

APR 07 1998

LAND CORNER RECORDATION CERTIFICATE
Filing Requirement of Act 74, Mich. P.A. 1970
Chippewa County Remonumentation Corner

SECTION

\$7.00 LAND CORNER
\$2.00 HSSR
12 Mar 1998 12:54:25 PM Receipt #6527
RECEIVED FOR RECORD
CHIPPewa COUNTY - STATE OF MICHIGAN
SHARON H. KENNEDY, REGISTER OF DEEDS
BOOK 10 PAGE 238

Register of Deeds Stamp & File Number

For corners in

Chippewa

Located In:

Corner Code #

1. Public Land Survey

T 46N R 2W

I-10

2. Property Controlling in Section

S T R

3. Miscellaneous

S T R

Property in Sec.


S T R

4. Lot No. Recorded Plat

5. Private Claims

I, William L. Karr, in a field survey on November 25, 1997, do hereby state that under requirements of P.A. 74, Michigan P.A. of 1970, the corner points mentioned in lines 1 and 2 above were in conformance with regulations and rules therefore as required in the current manual of survey instructions of the United States Department of the Interior, Bureau of Land Management or by a decree of a Court of Law and/or that the corner points mentioned in lines 3, 4 and 5 above were in conformance with the rules of the Michigan Board of Land Surveyors or by a Decree of a Court of Law; established, re-established, monumented, recovered, found as expressed below:

NOTE: Not more than 2 corners, all in the same town and range, may be recorded on this certificate.

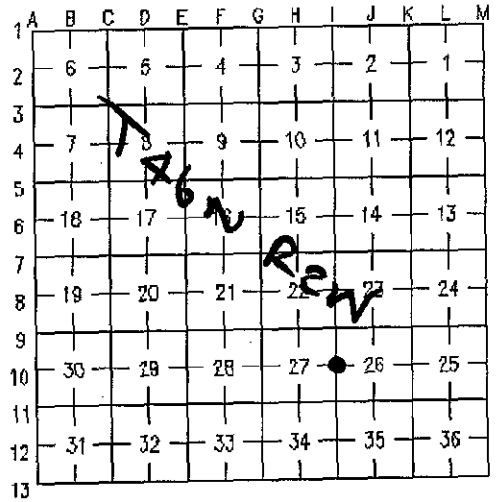

A. Description of original monument and accessories and/or subsequent restoration:

(I-10) 1/4 Corner Common to Sections 26 and 27, T.46 N., R.2 W.
1849 Harvey Meilen set Spruce post in original survey. Witnesses:

Spruce 7 S22°E 16
Y. Birch 15 N69°W 60

Found no record of subsequent restoration.



B. Description of corner evidence found and/or method applied in restoring or reestablishing corner:

(I-10) 1/4 Corner Common to Sections 26 and 27, T.46 N., R.2 W.
This corner is being perpetuated as part of the Chippewa County Remonumentation Program.


Found no evidence of the original corner. Found a 1" pipe (bent) in approximate road centerlines to the North and West. There are several North-South fence lines to the South. The corner falls on the extension of the Westerly fence line. Accepted the pipe as the best available evidence for the corner and replaced the bent pipe. Corner is 7.58' East of a straight line between the Section corners. Distance North is 2634.53'; distance South is 2641.39'.

C. Description of monument for corner and accessories established to perpetuate locating the position of the corner:

(I-10) 1/4 Corner Common to Sections 26 and 27, T.46 N., R.2 W.

Corner is a 3/4" x 24" iron with plastic Chippewa County Remonumentation Corner cap on intersecting centerlines of roads to North and West and on the extension of an old fence to the South.

Witnesses: Balsam 12" N40°E 39.87'
Spruce 3" S43°E 26.95'
J. Pine 10" S60°W 49.78'
Spruce 6" N64°W 43.80'

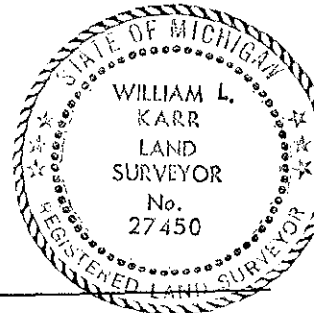

Signed by [Signature]

Date 12/23/97

Surveyor's Michigan License No. 27450

NOTE: All bearings are compass bearings corrected for declination (6°W). All distances are to a nail and tag in the side of witness object unless otherwise noted.