

APR 07 1998

LAND CORNER RECORDATION CERTIFICATE
 Filing Requirement of Act 74, Mich. P.A. 1970
 Chippewa County Remonumentation Corner

SECTION

For corners in


<u>Chippewa</u>	Located In:	Corner Code #
1. Public Land Survey	T <u>46N</u> R <u>2W</u>	<u>I-11</u>
	T ___ R ___	
	T ___ R ___	
	T ___ R ___	
2. Property Controlling in Section	S ___ T ___ R ___	
	S ___ T ___ R ___	
3. Miscellaneous Property in Sec.	S ___ T ___ R ___	
	S ___ T ___ R ___	

\$7.00 LAND CORNER
 \$2.00 MSSR
 12 Mar 1998 12:54:51 PM Receipt #6527
 RECEIVED FOR RECORD
 CHIPPewa COUNTY - STATE OF MICHIGAN
 SHARON H. KENNEDY, REGISTER OF DEEDS
 BOOK 10 PAGE 239
 Register of Deeds Stamp & File Number

4. Lot No. _____, Recorded Plat _____
 5. Private Claims _____


I, William L. Karr, in a field survey on November 25, 1997, do hereby state that under requirements of P.A. 74, Michigan P.A. of 1970, the corner points mentioned in lines 1 and 2 above were in conformance with regulations and rules therefore as required in the current manual of survey instructions of the United States Department of the Interior, Bureau of Land Management or by a decree of a Court of Law and/or that the corner points mentioned in lines 3, 4 and 5 above were in conformance with the rules of the Michigan Board of Land Surveyors or by a Decree of a Court of Law; established, re-established, monumented, recovered, found as expressed below:

NOTE: Not more than 2 corners, all in the same town and range, may be recorded on this certificate.

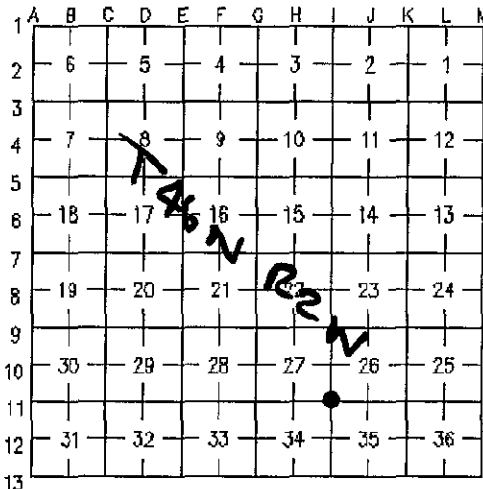

A. Description of original monument and accessories and/or subsequent restoration:

(I-11) Section Corner Common to Sections 26, 27, 34 and 35, T.46 N., R.2 W.
 1849 Harvey Mellen set Spruce post in original survey. Witnesses: W. Pine 40 S18°E 27'
 Spruce 40 S55°W 55'
 1893 F.H. Brown surveyed Section 35 and noted a cement post and Cedar 6".
 1927 F.H. Brown resurveyed Section 35; distance on West side of the Section was 5278; distance on North side of Section was 5290.
 1/4 corner to the East was mentioned. 1/4 corner to the South (34/35) was noted as 2639'.

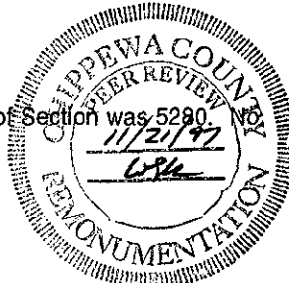

B. Description of corner evidence found and/or method applied in restoring or reestablishing corner:

(I-11) Section Corner Common to Sections 26, 27, 34 and 35, T.46 N., R.2 W.
 This corner is being perpetuated as part of the Chippewa County Remonumentation Program.

Found no evidence of the original corner or subsequent restoration. It appears that an East-West road was constructed in this area many years ago and then abandoned. There are (2) fences to the North, 1 obvious fence to the South and the remains of a second very old fence to the South. There is also an East-West fence that appears to have been built on the North side of the old lane. The old fence line to the South is on the extension of 1/4 corner 34/35 and Section corner 34, 35, 2 and 3. Used the old fence to the South for an East-West location and split the distance between 1/4 corner 26/27 and 1/4 corner 34/35. (Distance between the 1/4 corners is 5282.71; GLO was 5280). This position also matched the Westerly fence to the North. Distance East to Section corner 25, 26, 35 and 36 is 5273.90'.

C. Description of monument for corner and accessories established to perpetuate locating the position of the corner:

(I-11) Section Corner Common to Sections 26, 27, 34 and 35, T.46 N., R.2 W.
 Corner is a 3/4" x 24" iron with aluminum Chippewa County Remonumentation Corner cap and falls on the extension of an old fenceline to the North and in an old East-West road bed.

Witnesses: W. Birch 6" N38°E 11.24'
 W. Birch 6" S52°E 11.72'
 W. Birch 6" S28°W 44.75'
 Triple W. Birch 8" N52°W 55.79'



Signed by William L. Karr Date 12/21/97

Surveyor's Michigan License No. 27450

NOTE: All bearings are compass bearings. Corrected for declination (W), all distances are to a nail and tag in the side of witness object unless otherwise noted.