

SURVEY &
REMONUMENTATION

CHIPPEWA COUNTY REMONUMENTATION CORNER

MAY 28 1997

LAND CORNER RECORDATION CERTIFICATE
Filing Requirement of Act 74, Mich. P.A. 1970

For corners in
Chippewa
(County)

Located In: Corner Code #

- | | | |
|------------------------------------|----------------------------|-------|
| 1. Public Land Survey | T <u>46</u> N R <u>2</u> W | J-5 |
| | T ___ R ___ | _____ |
| | T ___ R ___ | _____ |
| | T ___ R ___ | _____ |
| 2. Property Controlling in Section | S ___ T ___ R ___ | _____ |
| | S ___ T ___ R ___ | _____ |
| 3. Miscellaneous Property in Sec. | S ___ T ___ R ___ | _____ |
| | S ___ T ___ R ___ | _____ |

\$2.00 MSSR
3/4/1997 2:36:41 PM Receipt #294
RECEIVED FOR RECORD
CHIPPEWA COUNTY - STATE OF MICHIGAN
SHARON H. KENNEDY, REGISTER OF DEEDS


BOOK 10 PAGE 91

Register of Deeds Stamp & File Number

4. Lot No. _____, Recorded Plat _____
5. Private Claims _____

I, William L. Karr, in a field survey on Dec. 18, 1996 do hereby state that under requirements of P.A. 74, Michigan P.A. of 1970, the corner points mentioned in lines 1 and 2 above were in conformance with regulations and rules therefore as required in the current manual of survey instructions of the United States Department of the Interior, Bureau of Land Management or by a decree of a Court of Law and/or that the corner points mentioned in lines 3, 4 and 5 above were in conformance with the rules of the Michigan Board of Land Surveyors or by a Decree of a Court of Law; established, re-established, monumented, recovered, found as expressed below:

NOTE: Not more than 2 corners, all in the same town and range, may be recorded on this certificate.

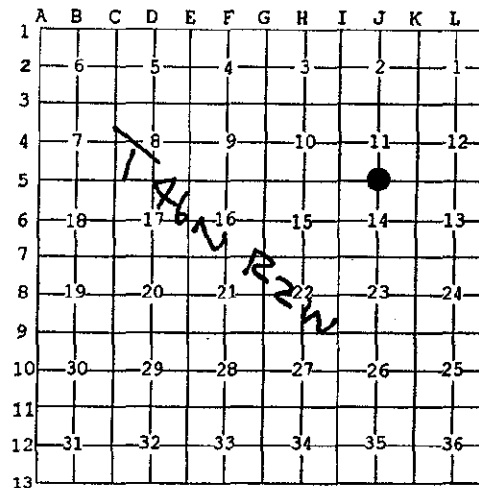

A. Description of original monument and accessories and/or subsequent restoration:

(J-5) 1/4 Corner Common to Sections 11 & 14, T.46 N., R.2 W.

1849: H. Mellen set post

Witnesses: Cedar 16 N80°E 30 Cedar 12 N72-1/2°W 12

1914: F.H. Brown County Surveyor surveyed Section 14 and notes North line split evenly.

1995: L.R. Rogers, P.S. 29251 re-constructed the North line of Section 14 per Brown's Notes and set 1/4 corner 11 & 14 mid-way and on-line. (4) witnesses were established.

B. Description of corner evidence found and/or method applied in restoring or reestablishing corner:

(J-5) This Corner is being perpetuated as part of the Chippewa County Remonumentation Program.

Found no evidence of original corner. Rogers' corner was removed during road construction. Accepted Rogers position for corner. Distance to the East and West is 2650.00' (C.S. is 2650.00'). Corner was replaced using existing traverse control along the North side of Section 14 and (2) remaining witnesses.


C. Description of monument for corner and accessories established to perpetuate locating the position of the corner:

(J-5) Corner is a 3/4" x 24" iron with plastic Chippewa County Remonumentation Corner falls 3.0' South of road centerline.

Witnesses: 12" Double Maple N24°E 33.68'
22" Spruce S55°E 169.04'
6" B. Spruce S36°W 31.77'
10" B. Spruce N55°W 52.60'

Signed by William L. Karr
Surveyor's Michigan License No. 27450

Date 12-30-96

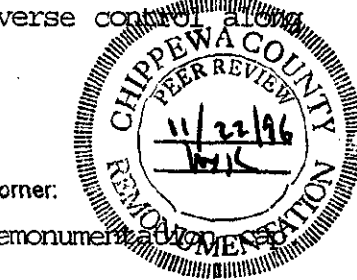

NOTE: All bearings are compass bearings corrected for declination. All distances are to a nail in side of witness objects unless noted.