MAR 27 1996

COMMISSION

CHIPPEWA COUNTY REMONUMENTATION CORNER

# LAND CORNER RECORDATION CERTIFICATE
**Filing Requirement of Act 74, Mich. P.A. 1970**

For corners in

Chippewa (County) Located In: Corner Code #

| | | | |
|---|---|---|---|
| 1. Public Land Survey | | T46N R2W | J-7 |
| | | T___ R___ | |
| | | T___ R___ | |
| | | T___ R___ | |
| 2. Property Controlling | S___ | T___ R___ | |
| in Section | S___ | T___ R___ | |
| 3. Miscellaneous | S___ | T___ R___ | |
| Property in Sec. | S___ | T___ R___ | |

$ 7.00 LAND CORNER
$ 2.00 MSSR
29 FEB 96 9:34 A.M. RECEIPT# 462
RECEIVED FOR RECORD
CHIPPEWA COUNTY - STATE OF MICHIGAN
SHARON H. KENNEDY, REGISTER OF DEEDS

Register of Deeds Stamp & File Number

4. Lot No. _____, Recorded Plat _____
5. Private Claims _____

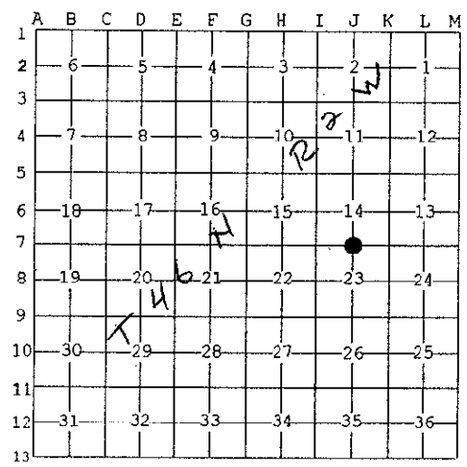


I, Larry R. Rogers, in a field survey on Oct. 10, 19 95 do hereby state that under requirements of P.A. 74, Michigan P.A. of 1970, the corner points mentioned in lines 1 and 2 above were in conformance with regulations and rules therefore as required in the current manual of survey instructions of the United States Department of the Interior, Bureau of Land Management or by a decree of a Court of Law and /or that the corner points mentioned in lines 3, 4 and 5 above were in conformance with the rules of the Michigan Board of Land Surveyors or by a Decree of a Court of Law; established, re-established, monumented, recovered, found as expressed below:

NOTE: Not more than 2 corners, all in the same town and range, may be recorded on this certificate.

A. Description of original monument and accessories and/or subsequent restoration:
(J-7) South 1/4 Corner of Section 14, T46N, R2W
1849: Harvey Mellen "set Tamarack post Qr. Section Corner" with the following witnesses:
9" W. Birch S75W 60 links 6" Fir S20W 29 links

1914: County Surveyor Fred Brown recorded the distance for the South line of Section 14 as 5307 feet (2663 West 1/2 - 2644 East 1/2).

B. Description of corner evidence found and/or method applied in restoring or reestablishing corner:
(J-7) This corner is being perpetuated as part of Chippewa County Remonumentation program.

Found no evidence of original corner position or any subsequent restoration. Distance from the Southwest corner of Section 14 to Southeast corner of Section 14 measures 5307.34 feet (Co. Surv. 5307). Re-established 1/4 corner position by single proportion using county surveyor distance from 1914 (2663.14 West 1/2 - 2644.14 East 1/2). Established four new witnesses.

CHIPPEWA COUNTY REMONUMENTATION PEER REVIEW 12/8/95

C. Description of monument for corner and accessories established to perpetuate locating the position of the corner:
(J-7) Corner is 3/4"x 24" iron with plastic "Chippewa County Remonumentation" cap 6.7 feet North of centerline of State Highway M-28.

| | | | |
|---|---|---|---|
| Witnesses: | 14" White Pine | N74°W | 160.69' |
| | Utility Pole (A) | N25°E | 59.06' |
| | Utility Pole (DR4/101) | S05°E | 60.17' |
| | Utility Pole (DR4/102) | S81°W | 324.14' |

STATE OF MICHIGAN
LARRY R. ROGERS
Land Surveyor
NO. 29251
LICENSED LAND SURVEYOR

Signed by _____ Date 30 DEC 1995
Surveyor's Michigan License No. 29251

NOTE: Bearings are compass bearings corrected for declination. Distances are to a nail in side of witness objects unless noted.

FORM APPROVED BY MICHIGAN STATE BOARD OF PROFESSIONAL SURVEYORS, JAN. 28, 1971
REVISED MAY 14, 1975
REVISED JAN., 1983
REVISED OCT., 1985