

APR 07 1998

LAND CORNER RECORDATION CERTIFICATE
Filing Requirement of Act 74, Mich. P.A. 1970
Chippewa County Remonumentation Corner

SECTION

For corners in

Chippewa

Located In:

Corner Code #

1. Public Land Survey

T 46N R 2W

J-9

2. Property Controlling in Section

S T R

3. Miscellaneous Property in Sec.

S T R

\$7.00 LAND CORNER
\$2.00 NSSR
12 Mar 1998 12:56:04 PM Receipt #6527
RECEIVED FOR RECORD
CHIPPEWA COUNTY - STATE OF MICHIGAN
SHARON H. KENNEDY, REGISTER OF DEEDS


BOOK 10 PAGE 242

Register of Deeds Stamp & File Number

4. Lot No. Recorded Plat
5. Private Claims

I, William L. Karr, in a field survey on November 14, 1997, do hereby state that under requirements of P.A. 74, Michigan P.A. of 1970, the corner points mentioned in lines 1 and 2 above were in conformance with regulations and rules therefore as required in the current manual of survey instructions of the United States Department of the Interior, Bureau of Land Management or by a decree of a Court of Law and/or that the corner points mentioned in lines 3, 4 and 5 above were in conformance with the rules of the Michigan Board of Land Surveyors or by a Decree of a Court of Law; established, re-established, monumented, recovered, found as expressed below:

NOTE: Not more than 2 corners, all in the same town and range, may be recorded on this certificate.

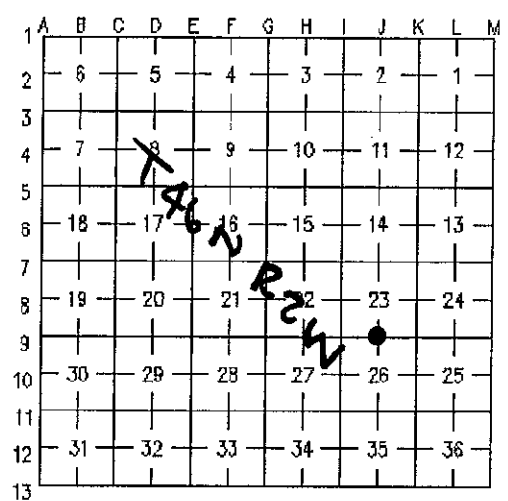

A. Description of original monument and accessories and/or subsequent restoration:

(J-9) 1/4 Corner Common to Sections 23 and 26, T.46 N., R.2 W.

1849 Harvey Mellen set Birch post in original survey. Witnesses: Cedar 10 S62°W 53
Spruce 9 N63°E 48

1929 County Surveyor notes show a distance of 2642' for West 1/2 mile.
??? County Surveyor notes show 2650' for East 1/2 mile and 5292' for entire mile.



B. Description of corner evidence found and/or method applied in restoring or reestablishing corner:

(J-9) 1/4 Corner Common to Sections 23 and 26, T.46 N., R.2 W.

This corner is being perpetuated as part of the Chippewa County Remonumentation Program.


Found no evidence of the original corner of subsequent restoration. Reestablished corner position on line between adjacent Section Corners and on the extension of a fence line to the South. Distance East is 2621.46' (C.S. 2650'); distance West is 2638.59' (C.S. 2642').

C. Description of monument for corner and accessories established to perpetuate locating the position of the corner:

(J-9) 1/4 Corner Common to Sections 23 and 26, T.46 N., R.2 W.

Corner is a 3/4" x 24" iron with plastic Chippewa County Remonumentation Corner cap, 4" below grade and falls on the centerline of 10 Mile road (East-West). Corner also falls on the extension of a fence line to the South.

Witnesses: 3/4" I.D. witness pipe N48°E 40.65'
3/4" I.D. witness pipe S47°E 78.30'
Power pole S06°W 51.97'
3/4" I.D. witness pipe N45°W 39.95'

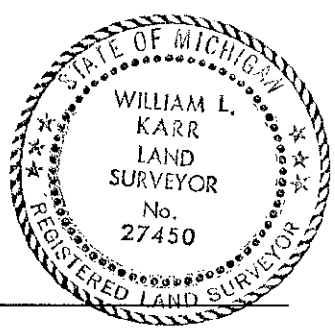

Signed by [Signature] Date 12/21/97

Surveyor's Michigan License No. 27450

NOTE: All bearings are compass bearings corrected for declination (6°W). All distances are to a nail and tag in the side of witness object unless otherwise noted.