

MAY 28 1997

COMMISSION

CHIPPEWA COUNTY REMONUMENTATION CORNER

LAND CORNER RECORDATION CERTIFICATE
Filing Requirement of Act 74, Mich. P.A. 1970 \$7.00 LAND CORNER

For corners in

<u>Chippewa</u> (County)	Located In:	Corner Code #
1. Public Land Survey	T <u>46N</u> R <u>2W</u>	<u>K-4</u>
	T ___ R ___	_____
	T ___ R ___	_____
	T ___ R ___	_____
2. Property Controlling in Section	S ___ T ___ R ___	_____
	S ___ T ___ R ___	_____
3. Miscellaneous Property in Sec.	S ___ T ___ R ___	_____
	S ___ T ___ R ___	_____

\$2.00 NSSR
3/4/1997 2:38:52 PM Receipt #294
RECEIVED FOR RECORD
CHIPPEWA COUNTY - STATE OF MICHIGAN
SHARON H. KENNEDY, REGISTER OF DEEDS


BOOK 10 PAGE 94

Register of Deeds Stamp & File Number

4. Lot No. _____, Recorded Plat _____
5. Private Claims _____

I, William L. Karr, in a field survey on Dec. 20, 1996 do hereby state that under requirements of P.A. 74, Michigan P.A. of 1970, the corner points mentioned in lines 1 and 2 above were in conformance with regulations and rules therefore as required in the current manual of survey instructions of the United States Department of the Interior, Bureau of Land Management or by a decree of a Court of Law and /or that the corner points mentioned in lines 3, 4 and 5 above were in conformance with the rules of the Michigan Board of Land Surveyors or by a Decree of a Court of Law; established, re-established, monumented, recovered, found as expressed below.

NOTE: Not more than 2 corners, all in the same town and range, may be recorded on this certificate.

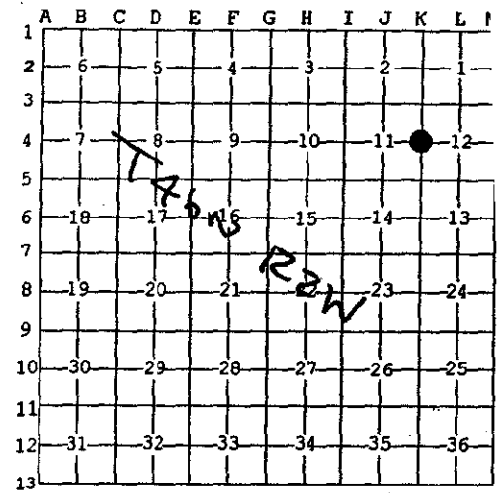

A. Description of original monument and accessories and/or subsequent restoration:

(K-4) 1/4 Corner Common to Sections 11 & 12, T.46 N., R.2 W.
1849: H. Mellen set post Hemlock 10 S5°E 28
Cedar 10 N7°W 22

19???: F.H. Brown, County Surveyor notes survey in Section 12 with considerable discussion.



B. Description of corner evidence found and/or method applied in restoring or reestablishing corner:

(K-4) This Corner is being re-established as part of the Chippewa County Remonumentation Program. Found no evidence of original corner. Considerable time was spent locating and evaluating fences in this area. It appears as if a lane and R.O.W. fences were constructed West of Forrest Side road on the E-W 1/4 line of Section 12. The R.O.W. being 33' wide. These fences stop at a small stream with an old bridge East of the 1/4 corner. A single fence continues West to the 1/4 corner area. There is also a N-S fence at the 1/4 corner. This was determined to be an old R.O.W. fence since the purpose of Brown's survey in Section 12 was for a Township road. We reestablished the corner 16.5' West of this fence and midway between the Section corners. This gives us a South 1/2 mile of 2641.33' C.S.-2637') and is 24.5' North and 16.5' West of an existing fence corner. The corner is also 1.31' East of a straight line between Section corners.

C. Description of monument for corner and accessories established to perpetuate locating the position of the corner:

(K-4) Corner is a 3/4" iron with plastic Chippewa County Remonumentation cap.

Witnesses:	4" Spruce	N54°E	32.67'
	7" Spruce	S78°E	58.12'
	6" Spruce	S23°W	69.02'
	8" Spruce	N05°W	42.13'



Signed by William L. Karr
Surveyor's Michigan License No. 27450

Date 12-30-96

NOTE: All bearings are compass bearings corrected for declination. All distances are to a nail in side of witness objects unless noted.