

SURVEY & REMONUMENTATION

1993

COMMISSION

Chippewa County Remonumentation Corner

LAND CORNER RECORDATION CERTIFICATE

Filing Requirement of Act 74, Mich. P.A. 1970

RECEIVED FOR RECORD  
CHIPPEWA COUNTY  
STATE OF MICHIGAN

93 NOV 31 AM 10:09

*J. Roger Malott*

REGISTER OF DEEDS

Register of Deeds Stamp & File Number

For corners in

Chippewa

(County)

Located In:

Corner Code #

1. Public Land Survey	T 46N R 2W	<u>L-1</u> Same
	T 47N R 2W	<u>L-13</u> Corner
	T _____ R _____	_____
	T _____ R _____	_____
2. Property Controlling In Section	S _____ T _____ R _____	_____
	S _____ T _____ R _____	_____
3. Miscellaneous Property In Sec.	S _____ T _____ R _____	_____
	S _____ T _____ R _____	_____

4. Lot No. \_\_\_\_\_, Recorded Plat \_\_\_\_\_  
5. Private Claims \_\_\_\_\_

I, William L. Karr, in a field survey on May 25, 19 93, do hereby certify that under requirements of P.A. 74, Michigan P.A. of 1970, the corner points mentioned in lines 1 and 2 above were in conformance with regulations and rules therefore as required in the current manual of survey instructions of the United States Department of the Interior, Bureau of Land Management or by a decree of a Court of Law and/or that the corner points mentioned in lines 3, 4 and 5 above were in conformance with the rules of the Michigan Board of Land Surveyors or by a Decree of a Court of Law; established, re-established, monumented, re-monumented, recovered, found as expressed below:

**NOTE: Not more than 4 corners, all in the same town and range, may be recorded on this certificate.**

A. Description of original monument and accessories and/or subsequent restoration:

(L-1) North 1/4 Corner Section 1

1987 William L. Karr, L.S. 27450 Recorded in Liber 6, Page 365 of Corner Records.

Set 1/2" iron L.S. 27450

8" Poplar	N04°E	60.92'
20" Spruce	N22°E	78.31'
10" Red Pine	S21°E	47.90'
Power Pole	S63°W	119.26'

B. Description of corner evidence found and/or method applied in restoring or reestablishing corner:

(L-1) This corner is being perpetuated as part of the Chippewa County Remonumentation Program.



Found record corner and (3) record ties.  
Added an additional tie.  
Accepted corner position as found.

C. Description of monument for corner and accessories established to perpetuate locating the position of the corner:

(L-1) Corner is a 1/2" iron L.S. 27450 in a monument box 0.5' North of the centerline of 6 Mile Road and approximately 3' West of centerline of Forrest Side Road to South.

Witnesses: 8" Poplar	N04°E	60.92'
20" Spruce	N22°E	78.22'
Power Pole (E-124)	S63°W	119.19'
4" Triple Maple	S46°E	62.92'

	A	B	C	D	E	F	G	H	I	J	K	L	M
2	6	5	4	3	2								
3													
4	7	8	9	10	11	12							
5													
6	18	17	16	15	14	13							
7													
8	19	20	21	22	23	24							
9													
10	30	29	28	27	26	25							
11													
12	31	32	33	34	35	36							
13													

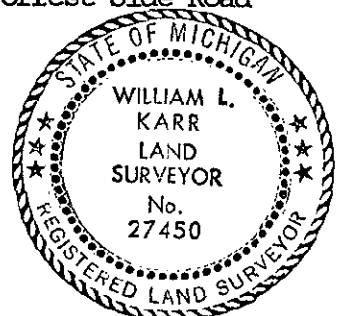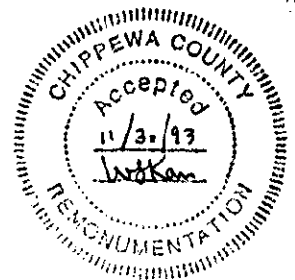

Signed by William L. Karr

Date 11/12/93

Surveyor's Michigan License No. 27450

NOTE: Bearings are compass bearings corrected for declination.  
Distances are to a nail in side of witness objects unless noted.