

MAY 28 1997

CHIPPEWA COUNTY REMONUMENTATION CORNER

COMMISSION

LAND CORNER RECORDATION CERTIFICATE  
Filing Requirement of Act 74, Mich. P.A. 1970 \$7.00 LAND CORNER

For corners in

<u>Chippewa</u> (County)	Located In:	Corner Code #
1. Public Land Survey	T <sup>46</sup> N R 2W	L-3
	T___ R___	_____
	T___ R___	_____
	T___ R___	_____
2. Property Controlling in Section	S___ T___ R___	_____
	S___ T___ R___	_____
3. Miscellaneous Property in Sec.	S___ T___ R___	_____
	S___ T___ R___	_____

\$2.00 MSSR  
3/4/1997 2:40:55 PM Receipt #294  
RECEIVED FOR RECORD  
CHIPPEWA COUNTY - STATE OF MICHIGAN  
SHARON H. KENNEDY, REGISTER OF DEEDS

BOOK 10 PAGE 97

Register of Deeds Stamp & File Number

4. Lot No. \_\_\_\_\_, Recorded Plat \_\_\_\_\_  
5. Private Claims \_\_\_\_\_

I, William L. Karr, in a field survey on Dec. 16, 1996 do hereby state that under requirements of P.A. 74, Michigan P.A. of 1970, the corner points mentioned in lines 1 and 2 above were in conformance with regulations and rules therefore as required in the current manual of survey instructions of the United States Department of the Interior, Bureau of Land Management or by a decree of a Court of Law and/or that the corner points mentioned in lines 3, 4 and 5 above were in conformance with the rules of the Michigan Board of Land Surveyors or by a Decree of a Court of Law; established, re-established, monumented, recovered, found as expressed below.

NOTE: Not more than 2 corners, all in the same town and range, may be recorded on this certificate.

A	B	C	D	E	F	G	H	I	J	K	L
1											
2	6		5		4		3		2		1
3											
4	7				9		10		11		12
5											
6	10		17		16		15		14		13
7											
8	19		20		21		22		23		24
9											
10	30		29		28		27		26		25
11											
12	31		32		33		34		35		36
13											

A. Description of original monument and accessories and/or subsequent restoration:

(L-3) 1/4 Corner Common to Sections 1 & 12, T.46 N., R.2 W.  
1849: H. Mellen set post Sugar 9 N55°E 21 Sugar 7 S70°W 13  
1983: W.L. Karr, P.S. 27450 found a 3/4" pipe in the road. Corner position was accepted and recorded in Liber 6, Page 28 of the Chippewa County Corner Records.

B. Description of corner evidence found and/or method applied in restoring or reestablishing corner:

(L-3) This Corner is being perpetuated as part of the Chippewa County Remonumentation Program.

Found no evidence of original corner. Found 3/4" pipe as described in 1983 but disturbed. Reset corner from one remaining witness and adjacent corners from previous survey. Accepted 1983 position for corner.



C. Description of monument for corner and accessories established to perpetuate locating the position of the corner:

(L-3) Corner is a 3/4" x 24" iron with plastic Chippewa County Remonumentation Corp. Corner falls in the centerline of Forrest Side road.

Witnesses:	Power pole (#37)	S88°E	22.07'
	7" Spruce	S34°E	69.72'
	Ctr (buried) cable box	S25°W	54.36'
	Corner fence post	N44°W	58.10'

Signed by William L. Karr  
Surveyor's Michigan License No. 27450

Date 12-30-96

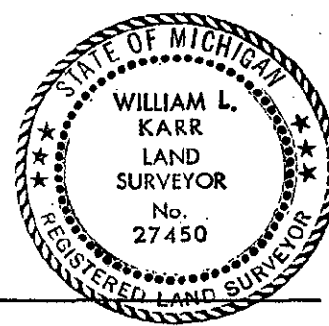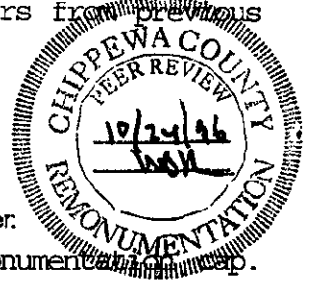

NOTE: All bearings are compass bearings corrected for declination. All distances are to a nail in side of witness objects unless noted.