

CHIPPEWA COUNTY REMONUMENTATION CORNER

MAR 27 1996

LAND CORNER RECORDATION CERTIFICATE
Filing Requirement of Act 74, Mich. P.A. 1970

For corners in

<u>Chippewa</u> (County)	Located In:	Corner Code #
1. Public Land Survey	T <u>46N</u> 2W	<u>L-7</u>
	T ___ R ___	___
	T ___ R ___	___
	T ___ R ___	___
2. Property Controlling in Section	S ___ T ___ R ___	___
	S ___ T ___ R ___	___
3. Miscellaneous Property in Sec.	S ___ T ___ R ___	___
	S ___ T ___ R ___	___


\$ 7.00 LAND CORNER
\$ 2.00 MSSR
29 FEB 96 9:35 A.M. RECEIPT# 462
RECEIVED FOR RECORD
CHIPPEWA COUNTY - STATE OF MICHIGAN
SHARON H. KENNEDY, REGISTER OF DEEDS

Register of Deeds Stamp & File Number

4. Lot No. _____, Recorded Plat _____
5. Private Claims _____

I, Larry R. Rogers, in a field survey on Oct. 10, 19 95 do hereby state that under requirements of P.A. 74, Michigan P.A. of 1970, the corner points mentioned in lines 1 and 2 above were in conformance with regulations and rules therefore as required in the current manual of survey instructions of the United States Department of the Interior, Bureau of Land Management or by a decree of a Court of Law and/or that the corner points mentioned in lines 3, 4 and 5 above were in conformance with the rules of the Michigan Board of Land Surveyors or by a Decree of a Court of Law; established, re-established, monumented, recovered, found as expressed below:

NOTE: Not more than 2 corners, all in the same town and range, may be recorded on this certificate.

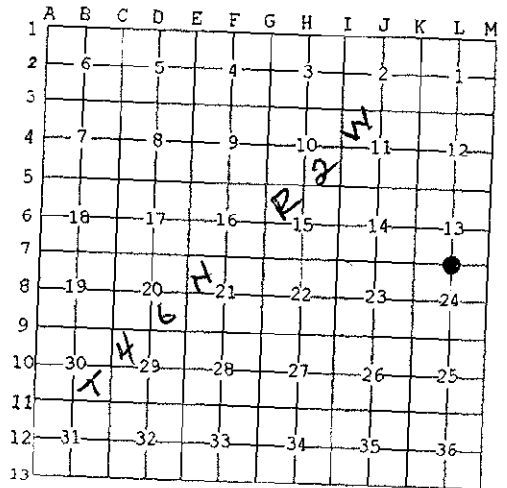

A. Description of original monument and accessories and/or subsequent restoration:

(L-7) South 1/4 Corner of Section 13, T46N, R2W
1849: Harvey Mellen "set Mountain Ash post or Section Corner" with the following witnesses:
6" Spruce N2½E 44 links 12" White Pine S88W 22 links
1973: County Surveyor N.D. Alix, P.S. 6254 set 1/4 corner midway and on-line between Southwest corner and Southeast corner of Section 13.
1992: Michigan Department of Transportation placed monumentation box over found "Alix" Corner.

B. Description of corner evidence found and/or method applied in restoring or reestablishing corner:
(L-7) This corner is being perpetuated as part of Chippewa County Remonumentation program.


Found no evidence of original corner position. Found 1/2" iron pin in monument box midway and on-line between Southwest and Southeast corners of Section 13. Monument Box is 18.5 feet South of centerline of State Highway M-28 and 6" below ground surface in South shoulder of road. Accepted corner position as found and established four new witnesses.

C. Description of monument for corner and accessories established to perpetuate locating the position of the corner:
(L-7) Corner is 1/2" iron pin in monument box, 18.5 feet South of centerline of State Highway M-28 and below ground shoulder.

Witnesses: 14" Tamarack	N55°W	111.48'
10" White Birch	N62°E	104.99'
Utility Pole	S59°E	165.29'
Utility Pole	S68°W	158.98'

Signed by [Signature]
Surveyor's Michigan License No. 29251

Date 30 DEC 1995

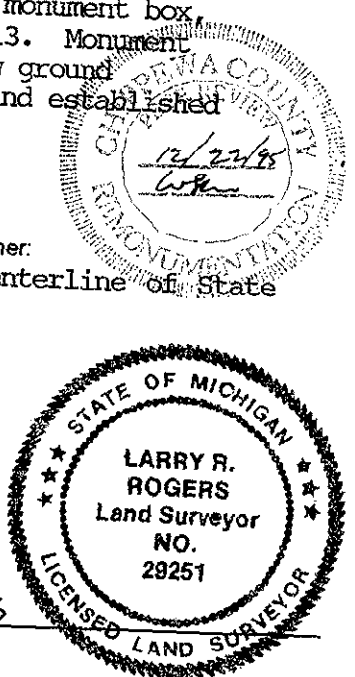

NOTE: Bearings are compass bearings corrected for declination. Distances are to a nail in side of witness objects unless noted.

FORM APPROVED BY MICHIGAN STATE BOARD OF PROFESSIONAL SURVEYORS, JAN. 28, 1971
REVISED MAY 14, 1975
REVISED JAN., 1983
REVISED OCT., 1995