SURVEY &
REMONUMENTATION

APR 07 1998

LAND CORNER RECORDATION CERTIFICATE

Filing Requirement of Act 74, Mich. P.A. 1970

Chippewa County Remonumentation Corner

$7.00 LAND CORNER
$2.00 MSSR
12 Mar 1998 1:02:21 PM Receipt #6527
RECEIVED FOR RECORD
CHIPPEWA COUNTY - STATE OF MICHIGAN
SHARON H. KENNEDY, REGISTER OF DEEDS
BOOK 10 PAGE 249

Register of Deeds Stamp & File Number

For corners in SECTION

Chippewa	Located In:	Corner Code #
1. Public Land Survey	T 46N R 2W	L-9
	T ___ R ___	
	T ___ R ___	
	T ___ R ___	
2. Property Controlling	S ___ T ___ R ___	
in Section	S ___ T ___ R ___	
3. Miscellaneous	S ___ T ___ R ___	
Property in Sec.	S ___ T ___ R ___	

4. Lot No._____, Recorded Plat _____
5. Private Claims _____

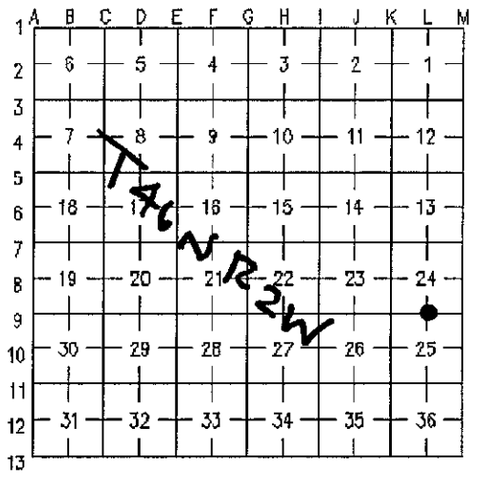

I, William L. Karr, in a field survey on November 26, 1997, do hereby state that under requirements of P.A. 74, Michigan P.A. of 1970, the corner points mentioned in lines 1 and 2 above were in conformance with regulations and rules therefore as required in the current manual of survey instructions of the United States Department of the Interior, Bureau of Land Management or by a decree of a Court of Law and/or that the corner points mentioned in lines 3, 4 and 5 above were in conformance with the rules of the Michigan Board of Land Surveyors or by a Decree of a Court of Law; established, re-established, monumented, recovered, found as expressed below:

NOTE: Not more than 2 corners, all in the same town and range, may be recorded on this certificate.

A. Description of original monument and accessories and/or subsequent restoration:

(L-9) 1/4 Corner Common to Sections 24 and 25, T.46 N., R.2 W.
1849 Harvey Mellen set Birch post in original survey. Witnesses: B. Ash 5 N42°E 14
B. Ash 7 S75°W 7

1912 F.H. Brown notes that original bearing trees standing.
1924 Count Surveyor records show distance East as 2643'; distance West as 2665'.

CHIPPEWA COUNTY REMONUMENTATION PEER REVIEW 11/21/97

B. Description of corner evidence found and/or method applied in restoring or reestablishing corner:

(L-9) 1/4 Corner Common to Sections 24 and 25, T.46 N., R.2 W.
This corner is being perpetuated as part of the Chippewa County Remonumentation Program.

Found no evidence of the original corner. Found a 1/2" iron in the approximate road centerline and on the extension of fences to the North and South. Iron falls 7.15' North of a straight line between adjacent Section corners. Distance East is 2645.29'. (C.S. - 2643'; GLO - 2632.08'); distance West is 2661.94' (C.S.-2665'; GLO-2632.08'). Accepted corner position as found and established witnesses.

C. Description of monument for corner and accessories established to perpetuate locating the position of the corner:

(L-9) 1/4 Corner Common to Sections 24 and 25, T.46 N., R.2 W.

Corner is a 1/2" iron 3" below grade on the centerline of 10 Mile road (East-West) and on the extension of fence lines to the North and South.

Witnesses:			
	3/4" I.D. capped witness pipe	N52°E	70.19'
	3/4" I.D. capped witness pipe	S40°E	62.24'
	Power pole	S40°W	50.06'
	Fence post	N06°W	44.07'

Note: The witness pipes are 3/4"x24" pipes with caps set 1' below grade, the angle between the pipes being 88°12'04".

Signed by William L. Karr Date 12/29/97

STATE OF MICHIGAN WILLIAM L. KARR LAND SURVEYOR No. 27450 REGISTERED LAND

Surveyor's Michigan License No. 27450
NOTE: All bearings are compass bearings corrected for declination (6°W). All distances are to a nail and tag in the side of witness object unless otherwise noted.

FORM APPROVED BY MICHIGAN STATE BOARD OF PROFESSIONAL SURVEYORS, JAN. 28, 1971
REVISED MAY 14, 1975
REVISED JAN., 1983
REVISED OCT., 1995

wp:COR97/46N02W.L09

BOOK 10 PAGE 249