

DAFTER TWP

J

SURVEY & REMONUMENTATION

APR 07 1998

LAND CORNER RECORDATION CERTIFICATE
Filing Requirement of Act 74, Mich. P.A. 1970
Chippewa County Remonumentation Corner

For corners in SECTION

Chippewa Located In: Corner Code #
1. Public Land Survey T 46N R 2W L-11
2. Property Controlling in Section S T R
3. Miscellaneous Property in Sec. S T R

\$7.00 LAND CORNER
\$2.00 MSSR
12 Mar 1998 1:02:47 PM Receipt #6527
RECEIVED FOR RECORD
CHIPPewa COUNTY - STATE OF MICHIGAN
SHARON H. KENNEDY, REGISTER OF DEEDS
BOOK 10 PAGE 250

Register of Deeds Stamp & File Number

4. Lot No. Recorded Plat
5. Private Claims

I, William L. Karr, in a field survey on December 1, 1997, do hereby state that under requirements of P.A. 74, Michigan P.A. of 1970, the corner points mentioned in lines 1 and 2 above were in conformance with regulations and rules therefore as required in the current manual of survey instructions of the United States Department of the Interior, Bureau of Land Management or by a decree of a Court of Law and/or that the corner points mentioned in lines 3, 4 and 5 above were in conformance with the rules of the Michigan Board of Land Surveyors or by a Decree of a Court of Law; established, re-established, monumented, recovered, found as expressed below:

NOTE: Not more than 2 corners, all in the same town and range, may be recorded on this certificate.

Grid table with columns A-M and rows 1-13. Contains handwritten 'PEER REVIEW' and a dot in cell 11,36.

A. Description of original monument and accessories and/or subsequent restoration:

(L-11) 1/4 Corner Common to Sections 25 and 36, T.46 N., R.2 W.

1849 Harvey Mellen set Birch post in original survey. Witnesses: Cedar 12 N20°E 22 Spruce 12 S38°W 45

1992 B. Feldhauser, P.S. 10685 surveyed the Northeast 1/4 of the Northwest 1/4 and set 1/4 corner 25/36 mid way and in-line

B. Description of corner evidence found and/or method applied in restoring or reestablishing corner:

(L-11) 1/4 Corner Common to Sections 25 and 36, T.46 N., R.2 W.

This corner is being perpetuated as part of the Chippewa County Remonumentation Program.

Found no evidence of the original corner. Found a 1/2" iron believed to have been set by Feldhauser. Found iron was 2.21' East and 1.87' South of position as noted on survey. Located several other corners from 1992 survey and they were all in their correctly stated positions. Reset corner by single proportionate measurement (mid-way and on line between adjacent Section corners). This position matches the Feldhauser survey. Distance East and West is 2642.07'.



C. Description of monument for corner and accessories established to perpetuate locating the position of the corner:


(L-11) 1/4 Corner Common to Sections 25 and 36, T.46 N., R.2 W.

Corner is a 3/4" x 24" iron with plastic Chippewa County Remonumentation Corner cap and falls on the centerline of 11 Mile road (East-West) and on the extension of a fence to the North.

Witnesses: Power pole N74°E 129.57'
10" post S08°E 70.09'
6" pvc well casing S37°W 203.51'
J. Pine 6" N10°W 107.50'

Signed by [Signature]

Date 12/21/97

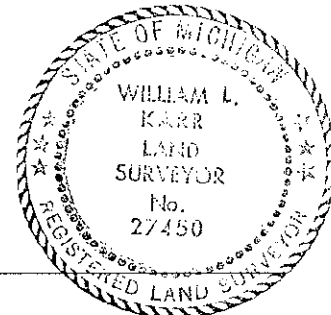

Surveyor's Michigan License No. 27450

NOTE: All bearings are compass bearings corrected for declination (6°W). All distances are to a nail and tag in the side of witness object unless otherwise noted.