

**SURVEY & REMONUMENTATION**

CHIPPEWA COUNTY REMONUMENTATION CORNER

APR 27 1995

**LAND CORNER RECORDATION CERTIFICATE**

Filing Requirement of Act 74, Mich. P.A. 1970

**COMMISSION**

For corners in

Chippewa  
(County)

Located In:


Corner Code #

- |                                       |                         |            |
|---------------------------------------|-------------------------|------------|
| 1. Public Land Survey                 | T 46N R 1W              | A-2 same   |
|                                       | T 46N R 2W              | M-2 corner |
|                                       | T _____ R _____         | _____      |
|                                       | T _____ R _____         | _____      |
| 2. Property Controlling in Section    | S _____ T _____ R _____ | _____      |
|                                       | S _____ T _____ R _____ | _____      |
| 3. Miscellaneous Property in Sec.     | S _____ T _____ R _____ | _____      |
|                                       | S _____ T _____ R _____ | _____      |
| 4. Lot No. _____, Recorded Plat _____ |                         |            |
| 5. Private Claims _____               |                         |            |

\$ 7.00 LAND CORNER  
 \$ 2.00 MSSR  
 19 DEC 94 10:20 A.M. RECEIVED  
 RECEIVED FOR RECORD  
 CHIPPEWA COUNTY - STATE OF MICHIGAN  
 SHARON H. KENNEDY, REGISTER OF DEEDS  
 Register of Deeds Stamp & File Number

I, William L. Karr, in a field survey on November 10, 1994, do hereby certify that under requirements of P.A. 74, Michigan P.A. of 1970, the corner points mentioned in lines 1 and 2 above were in conformance with regulations and rules therefore as required in the current manual of survey instructions of the United States Department of the Interior, Bureau of Land Management or by a decree of a Court of Law and/or that the corner points mentioned in lines 3, 4 and 5 above were in conformance with the rules of the Michigan Board of Land Surveyors or by a Decree of a Court of Law; established, re-established, monumented, re-monumented, recovered, found as expressed below:

**NOTE: Not more than 4 corners, all in the same town and range, may be recorded on this certificate.**

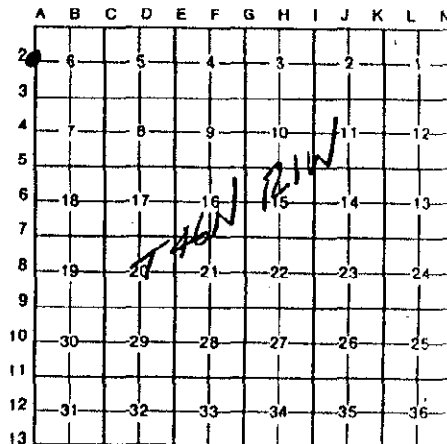

A. Description of original monument and accessories and/or subsequent restoration:

- (A-2) 1/4 Corner Section 6, T.46 N., R.1 W. and Section 1, T.46 N., R.2 W.  
 1840: A. Burt set post for corner Fir 5 S46W 28 lks Fir 4 N26W 29 lks  
 1905: County Surveyor notes show the West line of Section 6 as measuring 5260'  
 ? County Surveyor notes from the early 1900's show East line of Section 1 (T.46 N., R.2 W.) as measuring 5286'.  
 1982: W.L. Karr set a 1/2" iron w/cap No.27450 mid-way between right-of-way fences on abandoned Townline Road and on the extension of East-West 1/4 line fences. Corner was recorded in L.06, P.026 of corner records.

B. Description of corner evidence found and/or method applied in restoring or reestablishing corner:

(A-2) This corner is being perpetuated as part of the Chippewa County Remonumentation program.  
 Found no evidence of original corner. Found 1/2" iron w/cap No.27450 on the extension of an East-West 1/4 line fence. Distance North to the Township corner is 2640.98'. Distance South to Section Corner 6, 7, 12 & 1 is 2638.66'. Accepted corner position as found.

C. Description of monument for corner and accessories established to perpetuate locating the position of the corner:

(A-2) Corner is a 1/2" iron with cap No. 27450 on the extension of an East-West 1/4 line fence and in the center of abandoned Townline Road.

Witnesses: 6" Balsam Fir	N42°E	31.00'
10" Maple	S50°E	41.15'
10" Maple	S12°E	8.49'
10" Maple	S64°W	21.74'
8" Cedar	N48°W	29.94'



Signed by William L. Karr Date 12/8/94

Surveyor's Michigan License No. 27450

723-12

NOTE: Bearings are compass bearings corrected for declination.  
 Distances are to a nail in side of witness objects unless noted.