

**SURVEY &
REMONUMENTATION**

CHIPPEWA COUNTY REMONUMENTATION CORNER

APR 27 1995


LAND CORNER RECORDATION CERTIFICATE
Filing Requirement of Act 74, Mich. P.A. 1970

For corners **COMMISSION**

<u>Chippewa</u> <small>(County)</small>	Located In:	Corner Code #:
1. Public Land Survey	T <u>46N</u> R <u>1W</u>	<u>A-3</u> same
	T <u>46N</u> R <u>2W</u>	<u>M-3</u> corner
	T _____ R _____	_____
	T _____ R _____	_____
2. Property Controlling in Section	S _____ T _____ R _____	_____
	S _____ T _____ R _____	_____
3. Miscellaneous Property in Sec.	S _____ T _____ R _____	_____
	S _____ T _____ R _____	_____
4. Lot No. _____, Recorded Plat _____		
5. Private Claims _____		

\$ 7.00 LAND CORNER
\$ 2.00 MSSR
19 DEC 94 10:20 A.M. RECEIPT# 1769
RECEIVED FOR RECORD
CHIPPEWA COUNTY - STATE OF MICHIGAN
SHARON H. KENNEDY, REGISTER OF DEEDS
Register of Deeds Stamp & File Number

I, William L. Karr, in a field survey on November 10, 1994, do hereby certify that under requirements of P.A. 74, Michigan P.A. of 1970, the corner points mentioned in lines 1 and 2 above were in conformance with regulations and rules therefore as required in the current manual of survey instructions of the United States Department of the Interior, Bureau of Land Management or by a decree of a Court of Law and/or that the corner points mentioned in lines 3, 4 and 5 above were in conformance with the rules of the Michigan Board of Land Surveyors or by a Decree of a Court of Law; established, re-established, monumented, re-monumented, recovered, found as expressed below:

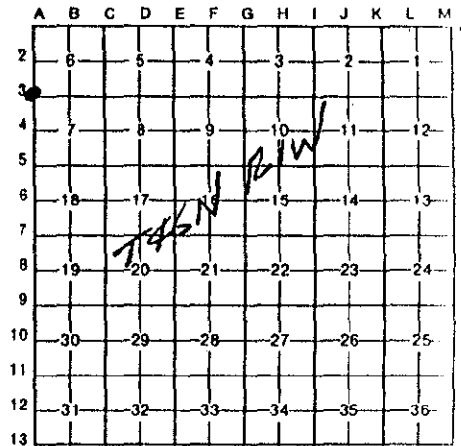

NOTE: Not more than 4 corners, all in the same town and range, may be recorded on this certificate.

A. Description of original monument and accessories and/or subsequent restoration:
(A-3) Section Corner 6 & 7, T.46 N., R.1 W. (Section Corner 1 & 12, T.46 N., R.2 W.)
1840: Austin Burt set post Fir 5 S08W 26 lks Tamarack 10 N56W 1 lks
1845: J. Mullett Spruce 12 S42E 10 lks Spruce 14 N57E 26 lks



B. Description of corner evidence found and/or method applied in restoring or reestablishing corner:
(A-3) This corner is being perpetuated as part of the Chippewa County Remonumentation program.
Found no evidence of original corner. Found a 4" diameter concrete monument in a 5" diameter steel pipe. Monument has "Chippewa County Corner" brass cap. Do not know the origin of the monument but is typical of those set in the late 1930's or early 1940's. There are fences at the 1/4 lines and South 1/16th lines