

SURVEY & REMONUMENTATION

MAY 28 1997

CHIPPEWA COUNTY REMONUMENTATION CORNER 7.00 LAND CORNER

LAND CORNER RECORDATION CERTIFICATE 2.00 NSSLR

Filing Requirement of Act 74, Mich. P.A. 1970 3/4/1997 2:15:44 PM

Receipt #294

For corners in **COMMISSION**

RECEIVED FOR RECORD
CHIPPEWA COUNTY - STATE OF MICHIGAN
SHARON H. KENNEDY, REGISTER OF DEEDS

BOOK 10 PAGE 69

Register of Deeds Stamp & File Number

Chippewa (County) Located In: Corner Code #

1. Public Land Survey T 46N R 2W E-1/E-2
T ___ R ___
T ___ R ___
T ___ R ___

2. Property Controlling in Section S ___ T ___ R ___
S ___ T ___ R ___


3. Miscellaneous Property in Sec. S ___ T ___ R ___
S ___ T ___ R ___

Other #4

4. Lot No. _____, Recorded Plat _____
5. Private Claims _____

I, William L. Karr, in a field survey on Dec. 6, 1996 do hereby state that under requirements of P.A. 74, Michigan P.A. of 1970, the corner points mentioned in lines 1 and 2 above were in conformance with regulations and rules therefore as required in the current manual of survey instructions of the United States Department of the Interior, Bureau of Land Management or by a decree of a Court of Law and /or that the corner points mentioned in lines 3, 4 and 5 above were in conformance with the rules of the Michigan Board of Land Surveyors or by a Decree of a Court of Law; established, re-established, monumented, recovered, found as expressed below.

NOTE: Not more than 2 corners, all in the same town and range, may be recorded on this certificate.

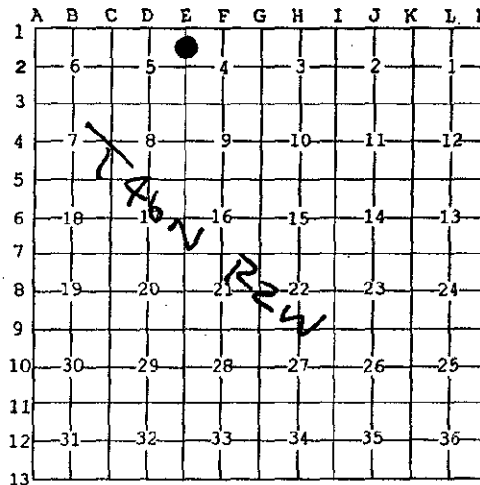

A. Description of original monument and accessories and/or subsequent restoration:

(E-1/E-2) Witness Corner to the Meander Corner (W.C.M.C.) Common to Sections 4 & 5, T.46 N., R.2 W.

1849: H. Mellen set post W. Birch 5 N77-1/2°E 94
W Pine 24 S17°W 94

1925: Plat of Jordan Beach, Superior Township recorded April 25, 1925 in Liber 4, Page 22 of Plats. Northwest corner of Lot 26 appears to be the W.C.M.C.

B. Description of corner evidence found and/or method applied in restoring or reestablishing corner:

(E-1/E-2) This Corner is being re-established as part of the Chippewa County Remonumentation Program.

Found no evidence of original corner position. Re-constructed the Northwest corner of Lot 26 (Northwest corner of plat) and set a 3/4" x 48" rebar with plastic Chippewa County Remonumentation cap for W.C.M.C.




(*There have been numerous surveys in this area. In my opinion, the best evidence for the W.C.M.C. is the 1925 Plat of Jordan Beach).

C. Description of monument for corner and accessories established to perpetuate locating the position of the corner:

(E-1/E-2) Corner is a 3/4" x 48" iron with plastic Chippewa County Remonumentation cap. Corner falls in the centerline of a 5' wide run-off creek, 50' South of water's edge.

Witnesses: 10" Maple S66°E 49.31'
9" W. Birch S43°E 23.42'
5" Tamarack S17°W 24.77'
12" Maple S75°W 108.27'

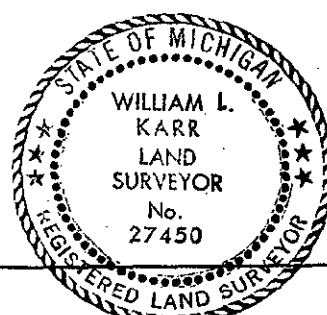

Signed by William L. Karr
Surveyor's Michigan License No. 27450

Date 12-30-96

NOTE: All bearings are compass bearings corrected for declination. All distances are to a nail in side of witness objects unless noted.