

**LAND CORNER RECORDATION CERTIFICATE**  
**Filing Requirement of Act 74, Mich. P.A. 1970**  
**Chippewa County Remonumentation Corner**

SECTION

For corners in

<b>Chippewa County</b>	Located in:	Corner Code #
1. Public Land Survey	T46N R7W T46N R6W T R T R	M-12 A-12 Same Corner
2. Property Controlling in Section	S T R S T R	
3. Miscellaneous Property in Sec.	S T R S T R	
4. Lot No.	Recorded Plat	
5. Private Claims		

BOOK **11** PAGE **127**

\$7.00 LAND CORNER  
 \$2.00 MSSR  
 23 FEB 2000 4:44:53 PM Receipt #2117  
 RECEIVED FOR RECORD  
 CHIPPEWA COUNTY - STATE OF MICHIGAN  
 SHARON H. KENNEDY, REGISTER OF DEEDS

Register of Deeds Stamp & File Number

I, Keith R. Waters, in a field survey on February 18, 1999, do hereby state that under requirements of P.A. 74, Michigan P.A. of 1970, the corner points mentioned in lines 1 and 2 above were in conformance with regulations and rules therefore as required in the current manual of survey instructions of the United States Department of the Interior, Bureau of Land Management or by a decree of a Court of Law and /or that the corner points mentioned in lines 3, 4 and 5 above were in conformance with the rules of the Michigan Board of Land Surveyors or by a Decree of a Court of Law, established, re-established, monumented, recovered, found as expressed below:

NOTE: Not more than 2 corners, all in the same town and range, may be recorded on this certificate.

	A	B	C	D	E	F	G	H	I	J	K	L	M
1													
2	6	5	4	3	2	1							
3													
4	7	8	9	10	11	12							
5													
6	18	17	16	15	14	13							
7													
8	19	20	21	22	23	24							
9													
10	30	29	28	27	26	25							
11													
12	31	32	33	34	35	36							
13													

A. Description of original monument and accessories and/or subsequent restoration:

M-12 (A-12) 1/4 Corner Common to Section 31, T46N, R6W & Section 36, T46N, R7W

1840 - Original corner established by Austin Burt.

Witnesses: Cedar 16, S70°W 07 links - Fir 6, N38°W 35 links.

1917 - Chippewa County Surveyor's notes indicate an original corner at this location.


Witnesses: Birch 12, Southeast 12' - Hemlock 12, Northeast 15'.

1936 - GLO Dependent Resurvey of T46N, R6W. Notes indicate no evidence of the original corner. Set corner at proportionate distance on line between M-11 and M-13. Set an iron post, 3 feet long, 2 inch diameter, 28 inches in the ground, with a stamped brass cap. Witnesses:

10" Cedar, S63 1/2°W 46 links

10" Spruce, S02°E 06 links

20" Hemlock, N89 1/4°E 48 links (marked "1/4 S" by a local surveyor)

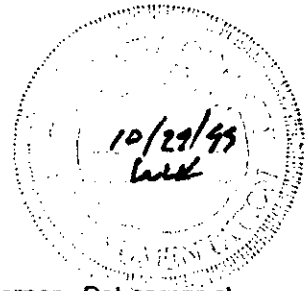

B. Description of corner evidence found and/or method applied in restoring or reestablishing corner:

This corner is being perpetuated as part of the Chippewa County Remonumentation Program.

Found a 2" iron pipe with a stamped brass cap as described in the above mentioned GLO Dependent Resurvey. None of the previous record bearing trees remain. A 14" hemlock with an aluminum tag stamped "78 lks" was found S82°E 51.7 feet (78.3 links) from the found pipe.

C. Description of monument for corner and accessories established to perpetuate locating the position of the corner:

Found a 2" diameter iron pipe with a stamped brass cap at the corner location.


Witnesses:

14" blazed Hemlock with aluminum tag stamped "78 lks", S82°E 51.70'

Nail and tag #33142 in 14" blazed Cedar, S06°E 38.93'

Nail and tag #33142 in 14" blazed Cedar, S86°W 36.80'

Nail and tag #33142 in 13" blazed Cedar, N20°W 18.21'

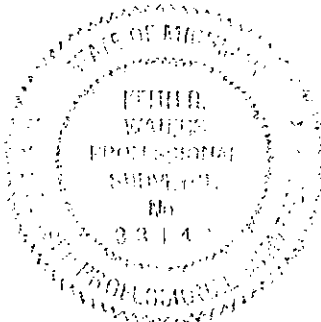

Signed by Keith R. Waters

Date 12-29-99

Surveyor's Michigan License No. 33142