

LAND CORNER RECORDATION CERTIFICATE
Filing Requirement of Act 74, Mich. P.A. 1970
Chippewa County Remonumentation Corner

SECTION

For corners in

| | | |
|------------------------------------|-------------|---------------|
| Chippewa County | Located in: | Corner Code # |
| 1. Public Land Survey | T46N R7W | E-11 |
| | T R | |
| | T R | |
| | T R | |
| 2. Property Controlling in Section | S T R | |
| 3. Miscellaneous Property in Sec. | S T R | |
| | S T R | |
| 4. Lot No. , Recorded Plat | | |
| 5. Private Claims | | |

BOOK **11** PAGE **98**

\$7.00 LAND CORNER
 \$2.00 MSSR
 23 FEB 2000 4:21:25 PM Receipt #21179
 RECEIVED FOR RECORD
 CHIPPEWA COUNTY - STATE OF MICHIGAN
 SHARON H. KENNEDY, REGISTER OF DEEDS
 Register of Deeds Stamp & File Number

I, Keith R. Waters, in a field survey on January 28, 1999, do hereby state that under requirements of P.A. 74, Michigan P.A. of 1970, the corner points mentioned in lines 1 and 2 above were in conformance with regulations and rules therefore as required in the current manual of survey instructions of the United States Department of the Interior, Bureau of Land Management or by a decree of a Court of Law and/or that the corner points mentioned in lines 3, 4 and 5 above were in conformance with the rules of the Michigan Board of Land Surveyors or by a Decree of a Court of Law; established, re-established, monumented, recovered, found as expressed below:

NOTE: Not more than 2 corners, all in the same town and range, may be recorded on this certificate.

A. Description of original monument and accessories and/or subsequent restoration:

E-11 Corner Common to Sections 28, 29, 32, & 33, T46N, R7W

1850 - Original corner established by Wells Burt, a spruce post.
 Witnesses: Tamarack 8, N14°E 27 links - Tamarack 12, S21°E 69 links.

1954 - Eino Sainio, P.S. 7873, Michigan Society of Registered Land Surveyors, Upper Peninsula Chapter, Land Corner Record, as recorded in liber 2, page 25, Chippewa County corner records. Found an old balsam stake point in the proper position in relation to recovered remains of the two original tamarack bearing trees. Set a 1 1/4" diameter iron pipe with a 3" diameter stamped brass cap. Also set a 4" diameter scribed cedar post next to the iron pipe. New witnesses:
 6" Cedar, N42°E 46 links
 7" Cedar, N62°W 34 links
 6" Cedar, S58°W 40 links
 6" Cedar, S10°E 27 links


B. Description of corner evidence found and/or method applied in restoring or reestablishing corner:

This corner is being perpetuated as part of the Chippewa County Remonumentation Program. Found a 1 1/4" iron pipe with a stamped brass cap next to a scribed cedar post and three of the record bearing trees as called for in the above mentioned 1954 Land Corner Record. Accepted corner as found and established an additional bearing tree.

C. Description of monument for corner and accessories established to perpetuate locating the position of the corner:

Found a 1 1/4" iron pipe with a 3" stamped brass cap at the corner location, next to a scribed cedar post.
 Witnesses:
 Nail and tag #33142 in 12" blazed Cedar, N42°E 29.21' (existing bearing tree)
 Nail and tag #33142 in 10" blazed Cedar, S10°E 18.60' (existing bearing tree)
 Nail and tag #33142 in 12" blazed Cedar, N62°W 21.55' (existing bearing tree)
 Nail and tag #33142 in 10" blazed Cedar, S51°W 30.15' (new bearing tree)

| | A | B | C | D | E | F | G | H | I | J | K | L | M |
|----|----|---|----|---|----|---|----|---|----|---|----|---|---|
| 1 | | | | | | | | | | | | | |
| 2 | 6 | | 5 | | 4 | | 3 | | 2 | | 1 | | |
| 3 | | | | | | | | | | | | | |
| 4 | 7 | | 8 | | 9 | | 10 | | 11 | | 12 | | |
| 5 | | | | | | | | | | | | | |
| 6 | 18 | | 17 | | 16 | | 15 | | 14 | | 13 | | |
| 7 | | | | | | | | | | | | | |
| 8 | 19 | | 20 | | 21 | | 22 | | 23 | | 24 | | |
| 9 | | | | | | | | | | | | | |
| 10 | 30 | | 29 | | 28 | | 27 | | 26 | | 25 | | |
| 11 | | | | | | | | | | | | | |
| 12 | 31 | | 32 | | 33 | | 34 | | 35 | | 36 | | |
| 13 | | | | | | | | | | | | | |

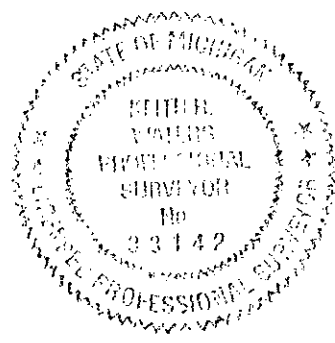

Signed by Keith R. Waters

Date 12-29-99

Surveyor's Michigan License No. 33142

FORM APPROVED BY MICHIGAN STATE BOARD OF PROFESSIONAL SURVEYORS, JAN. 28, 1971
 REVISED MAY 14, 1975
 REVISED JAN., 1983
 REVISED OCT., 1985

BOOK **11** PAGE **98**