

LAND CORNER RECORDATION CERTIFICATE
Filing Requirement of Act 74, Mich. P.A. 1970
Chippewa County Remonumentation Corner

SECTION

For corners in

Chippewa County	Located in:	Corner Code #
1. Public Land Survey	T46N R7W	F-11
	T R	
	T R	
	T R	
2. Property Controlling in Section	S T R	
	S T R	
3. Miscellaneous Property in Sec.	S T R	
	S T R	
4. Lot No.	Recorded Plat	
5. Private Claims		

BOOK 11 PAGE 99

\$7.00 LAND CORNER
\$2.00 MSSR
23 FEB 2000 4:22:50 PM Receipt #21179
RECEIVED FOR RECORD
CHIPPEWA COUNTY - STATE OF MICHIGAN
SHARON H. KENNEDY, REGISTER OF DEEDS

Register of Deeds Stamp & File Number

	A	B	C	D	E	F	G	H	I	J	K	L	M
1													
2	6		5		4		3		2		1		
3													
4	7		8		9		10		11		12		
5													
6	18		17		16		15		14		13		
7													
8	19		20		21		22		23		24		
9													
10	30		29		28		27		26		25		
11													
12	31		32		33		34		35		36		
13													

I, Keith R. Waters, in a field survey on November 9, 1999, do hereby state that under requirements of P.A. 74, Michigan P.A. of 1970, the corner points mentioned in lines 1 and 2 above were in conformance with regulations and rules therefore as required in the current manual of survey instructions of the United States Department of the Interior, Bureau of Land Management or by a decree of a Court of Law and /or that the corner points mentioned in lines 3, 4 and 5 above were in conformance with the rules of the Michigan Board of Land Surveyors or by a Decree of a Court of Law; established, re-established, monumented, recovered, found as expressed below:

NOTE: Not more than 2 corners, all in the same town and range, may be recorded on this certificate.

A. Description of original monument and accessories and/or subsequent restoration:

F-11 1/4 Corner Common to Sections 28 & 33, T46N, R7W

1850 - Original corner established by Wells Burt, a 4" Spruce.
Witness: Cedar 6, S01°E 08 links.

Found no evidence of subsequent restoration of this corner.


B. Description of corner evidence found and/or method applied in restoring or reestablishing corner:

This corner is being reestablished as part of the Chippewa County Remonumentation Program. Found no evidence of this corner. Reestablished corner by single proportionate measurement on line between the section corner at E-11 2611.8 feet to the west, and the section corner at G-11 2611.8 feet to the east.

C. Description of monument for corner and accessories established to perpetuate locating the position of the corner:

Placed a 3/4" x 24" rebar with a stamped aluminum Chippewa County Remonumentation cap at the corner location, which falls approximately 760 feet northwesterly of the old Soo Line Railroad grade. (As measured perpendicular to said grade). Witnesses:

- Nail and tag #33142 in 12" blazed Cedar, N23°W 22.65'
- Nail and tag #33142 in 8" blazed Tamarack, N89°E 18.32'
- Nail and tag #33142 in 10" blazed Cedar, S02°W 10.08'
- Nail and tag #33142 in 10" blazed Cedar, S80°W 5.38'

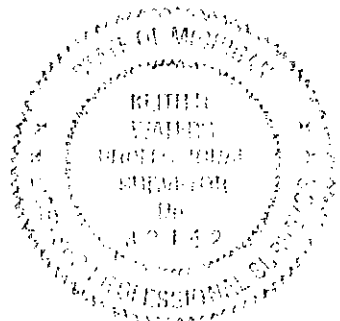

Signed by Keith R. Waters

Date 12-29-99

Surveyor's Michigan License No. 33142