

LAND CORNER RECORDATION CERTIFICATE
Filing Requirement of Act 74, Mich. P.A. 1970
Chippewa County Remonumentation Corner

SECTION

For corners in

Chippewa County	Located in:	Corner Code #
1. Public Land Survey	T46N R7W	G-9
	T R	
	T R	
	T R	
2. Property Controlling in Section	S T R	
	S T R	
3. Miscellaneous Property in Sec.	S T R	
	S T R	
4. Lot No. , Recorded Plat		
5. Private Claims		

BOOK **11** PAGE **100**

\$7.00 LAND CORNER
 \$2.00 MSSR
 23 FEB 2000 4:23:32 PM Receipt #21179
 RECEIVED FOR RECORD
 CHIPPEWA COUNTY - STATE OF MICHIGAN
 SHARON H. KENNEDY, REGISTER OF DEEDS

Register of Deeds Stamp & File Number

I, Keith R. Waters, in a field survey on October 18, 1999, do hereby state that under requirements of P.A. 74, Michigan P.A. of 1970, the corner points mentioned in lines 1 and 2 above were in conformance with regulations and rules therefore as required in the current manual of survey instructions of the United States Department of the Interior, Bureau of Land Management or by a decree of a Court of Law and /or that the corner points mentioned in lines 3, 4 and 5 above were in conformance with the rules of the Michigan Board of Land Surveyors or by a Decree of a Court of Law; established, re-established, monumented, recovered, found as expressed below:

NOTE: Not more than 2 corners, all in the same town and range, may be recorded on this certificate.

A. Description of original monument and accessories and/or subsequent restoration:

G-9 Corner Common to Sections 21, 22, 27, & 28, T46N, R7W

1850 - Original corner established by Wells Burt, a cedar post.

Witnesses: Beech 12, S57°E 42 links - Sugar 18, N09½°W 34 links.

1919 - Chippewa County Surveyor's notes indicate an original corner at this location.

Date Unknown - Penciled in entry in the original notes field book in the Chippewa County Surveyor's office, indicate a 3' x 2" iron pipe, centerline of road. Witnesses:

Iron Pipe, S43°E 45'

Balsam Fir, S53°W 61'

Balsam Fir, N42°E 90.5'

Balsam Fir, N61°E 69'

1993 - Certificate of Survey, Eino Sainio, P.S. 7873, as recorded in Liber 610, Page 721, Chippewa County Records
 The southeast corner of Section 21 is shown as a "C.C.R.C. corner."

B. Description of corner evidence found and/or method applied in restoring or reestablishing corner:

This corner is being perpetuated as part of the Chippewa County Remonumentation Program.

Found a badly bent 3 foot long, 2" diameter iron pipe in a monument box, fitting description as called for in the above mentioned undated Chippewa County Surveyor notes. Found no evidence of any of the record witness objects shown in said notes. Accepted corner location as found and replaced the bent pipe with a ½" rebar and cap #33142.

C. Description of monument for corner and accessories established to perpetuate locating the position of the corner:

Placed a ½" rebar with cap #33142 in a monument box at the corner location, replacing a found bent 2" iron pipe. Corner falls approximately 3.5 feet north of the centerline of an east-west bituminous road (Hulbert Road).

Witnesses:



Nail and tag #33142 in 26" Sugar Maple, S74°W 87.97'

Nail and tag #33142 in 30" Sugar Maple, N74°W 112.37'

Nail and tag #33142 in 16" Sugar Maple, N68°E 79.90'

Nail and tag #33142 in Power Pole (188/A), N62°E 60.15'

	A	B	C	D	E	F	G	H	I	J	K	L	M
1													
2	6		5		4		3		2		1		
3													
4	7		8		9		10		11		12		
5													
6	18		17		16		15		14		13		
7													
8	19		20		21		22		23		24		
9													
10	30		29		28		27		26		25		
11													
12	31		32		33		34		35		36		
13													

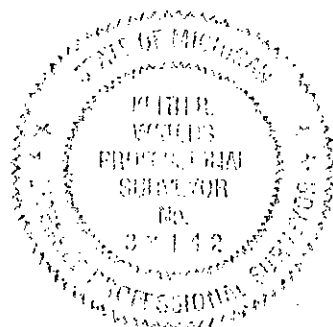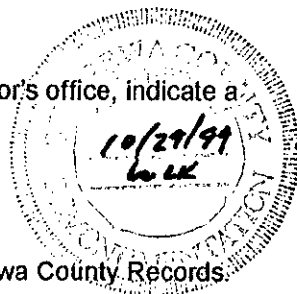

Signed by Keith R. Waters

Date 12-29-99

Surveyor's Michigan License No. 33142