LAND CORNER RECORDATION CERTIFICATE
Filing Requirement of Act 74, Mich. P.A. 1970
Chippewa County Remonumentation Corner

SECTION

For corners in

Chippewa County	Located in:			Corner Code #
1. Public Land Survey		T46N	R7W	G-10
		T	R	
		T	R	
		T	R	
2. Property Controlling	S	T	R	
in Section	S	T	R	
3. Miscellaneous	S	T	R	
Property in Sec.	S	T	R	

4. Lot No. , Recorded Plat
5. Private Claims

BOOK 11 PAGE 101

$7.00 LAND CORNER
$2.00 MSSR
23 FEB 2000 4:24:16 PM Receipt #2117
RECEIVED FOR RECORD
CHIPPEWA COUNTY - STATE OF MICHIGAN
SHARON H. KENNEDY, REGISTER OF DEEDS

Register of Deeds Stamp & File Number

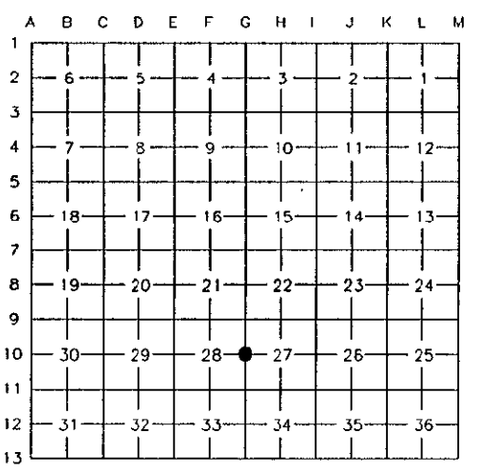

I, Keith R. Waters, in a field survey on November 23, 1999, do hereby state that under requirements of P.A. 74, Michigan P.A. of 1970, the corner points mentioned in lines 1 and 2 above were in conformance with regulations and rules therefore as required in the current manual of survey instructions of the United States Department of the Interior, Bureau of Land Management or by a decree of a Court of Law and /or that the corner points mentioned in lines 3, 4 and 5 above were in conformance with the rules of the Michigan Board of Land Surveyors or by a Decree of a Court of Law; established, re-established, monumented, recovered, found as expressed below:

NOTE: Not more than 2 corners, all in the same town and range, may be recorded on this certificate.

A. Description of original monument and accessories and/or subsequent restoration:

G-10 ¼ Corner Common to Sections 27 & 28, T46N, R7W

1850 – Original corner established by Wells Burt, an ironwood post.
Witnesses: Yellow Birch 16, N02°W 11 links – Hemlock 14, S30°E 43 links.
1919 – Chippewa County Surveyor's notes indicate an original corner at this location.
Date Unknown – Penciled in entry in the original notes field book in the Chippewa County Surveyor's office, indicate an iron pin and cedar post. Witnesses: 6" White Birch, N54°E 136.5' – 4" Yellow Birch, N55°E 97'.
1999 – Notes obtained from Eino Sainio, P.S. 7873, indicate a 1" pipe at the corner location. Witnesses:
8" Maple, N40°W 40.5'
7" Maple, N44°E 50.4'
3" x 3" Square Cedar Post, NORTH 15'
Axle Shaft and Fence Corner, NORTH 33'

CHIPPEWA COUNTY REMONUMENTATION 11/24/99 WRK

B. Description of corner evidence found and/or method applied in restoring or reestablishing corner:

This corner is being perpetuated as part of the Chippewa County Remonumentation Program. Found a 1" iron pipe 5.5 feet north of the centerline of an east-west 2 track road. Also found the four record witnesses as called for in Mr. Sainio's above mentioned notes. Accepted corner as found.

C. Description of monument for corner and accessories established to perpetuate locating the position of the corner:

Found a 1" iron pipe at the corner location, which falls 5.5 feet north of the centerline of an east-west 2 track road.
Placed a plastic Chippewa County Remonumentation cap inside the found pipe.
Witnesses:
Nail and tag #33142 in 8" Sugar Maple, N33°W 39.68' (existing bearing tree)
Nail and tag #33142 in 8" Sugar Maple, N48°E 49.72' (existing bearing tree)
Nail and tag #33142 in Power Pole, S50°W 73.48'
Found Axle Shaft (1¾" diameter, 2.5'± west of fence corner), N07°E 32.66'

STATE OF MICHIGAN KEITH R. WATERS PROFESSIONAL SURVEYOR No. 33142 LICENSED PROFESSIONAL SURVEYOR

Signed by Keith R. Waters Date 12-29-99

Surveyor's Michigan License No. 33142

FORM APPROVED BY MICHIGAN STATE BOARD OF PROFESSIONAL SURVEYORS, JAN. 28, 1971
REVISED MAY 14, 1975
REVISED JAN., 1983
REVISED OCT., 1995

T46N R7W G-10