

LAND CORNER RECORDATION CERTIFICATE
Filing Requirement of Act 74, Mich. P.A. 1970
Chippewa County Remonumentation Corner

SECTION

For corners in

Chippewa County	Located in:	Corner Code #
1. Public Land Survey	T46N R7W	H-9
	T R	
	T R	
	T R	
2. Property Controlling in Section	S T R	
	S T R	
3. Miscellaneous Property in Sec.	S T R	
	S T R	
4. Lot No. , Recorded Plat		
5. Private Claims		

BOOK **11** PAGE **105**

\$7.00 LAND CORNER
 \$2.00 MSSR
 23 FEB 2000 4:28:39 PM Receipt #21179
 RECEIVED FOR RECORD
 CHIPPEWA COUNTY - STATE OF MICHIGAN
 SHARON H. KENNEDY, REGISTER OF DEEDS
 Register of Deeds Stamp & File Number

I, Keith R. Waters, in a field survey on October 18, 1999, do hereby state that under requirements of P.A. 74, Michigan P.A. of 1970, the corner points mentioned in lines 1 and 2 above were in conformance with regulations and rules therefore as required in the current manual of survey instructions of the United States Department of the Interior, Bureau of Land Management or by a decree of a Court of Law and /or that the corner points mentioned in lines 3, 4 and 5 above were in conformance with the rules of the Michigan Board of Land Surveyors or by a Decree of a Court of Law; established, re-established, monumented, recovered, found as expressed below:

NOTE: Not more than 2 corners, all in the same town and range, may be recorded on this certificate.

A	B	C	D	E	F	G	H	I	J	K	L	M
1												
2	6	5	4	3	2	1						
3												
4	7	8	9	10	11	12						
5												
6	18	17	16	15	14	13						
7												
8	19	20	21	22	23	24						
9												
10	30	29	28	27	26	25						
11												
12	31	32	33	34	35	36						
13												

A. Description of original monument and accessories and/or subsequent restoration:


H-9 ¼ Corner Common to Sections 22 & 27, T46N, R7W

1850 – Original corner established by Wells Burt, a cedar post.
 Witnesses: Spruce 10, S76°W 08 links – Spruce 12, S32°E 19 links.

Found no evidence of subsequent restoration of this corner.

B. Description of corner evidence found and/or method applied in restoring or reestablishing corner:


This corner is being perpetuated as part of the Chippewa County Remonumentation Program.
 Found a 1¼" o.d. pipe at the approximate centerline P.I. of Hulbert Road to the south and to the west. The distance to the section corner at F-9 to the west is within 1.3 feet of the original GLO distance. Accepted corner as found and established witness objects.

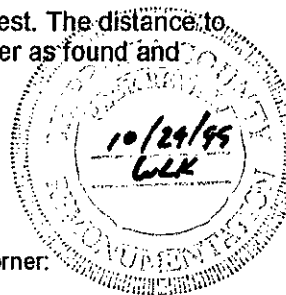

C. Description of monument for corner and accessories established to perpetuate locating the position of the corner:

Found a 1¼" pipe at the corner location, which falls at the approximate centerline P.I. of a bituminous road (Hulbert Road) to the south and to the west.

Witnesses:
 Nail and tag #33142 in 14" blazed Tamarack, N78°W 97.80'
 Nail and tag #33142 in 7" blazed Cedar, N17°W 95.40'
 Nail and tag #33142 in 8" blazed White Birch, N84°E 12.10'
 Nail and tag #33142 in 6" blazed Cedar, S41°E 74.81'

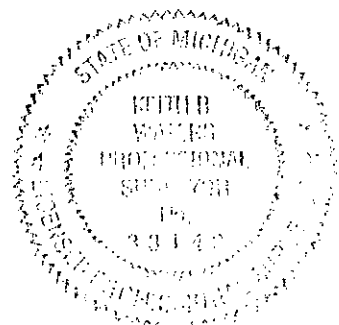

Signed by Keith R. Waters

Date 12-29-99

Surveyor's Michigan License No. 33142