

LAND CORNER RECORDATION CERTIFICATE
Filing Requirement of Act 74, Mich. P.A. 1970
Chippewa County Remonumentation Corner

SECTION

For corners in

Chippewa County	Located in:	Corner Code #
1. Public Land Survey	T46N R7W	I-9
	T R	
	T R	
	T R	
2. Property Controlling in Section	S T R	
	S T R	
3. Miscellaneous Property in Sec.	S T R	
	S T R	
4. Lot No. , Recorded Plat		
5. Private Claims		

BOOK **11** PAGE **108**

\$7.00 LAND CORNER
 \$2.00 MSSR
 23 FEB 2000 4:31:21 PM Receipt #21179
 RECEIVED FOR RECORD
 CHIPPEWA COUNTY - STATE OF MICHIGAN
 SHARON H. KENNEDY, REGISTER OF DEEDS

Register of Deeds Stamp & File Number

I, Keith R. Waters, in a field survey on November 3, 1999, do hereby state that under requirements of P.A. 74, Michigan P.A. of 1970, the corner points mentioned in lines 1 and 2 above were in conformance with regulations and rules therefore as required in the current manual of survey instructions of the United States Department of the Interior, Bureau of Land Management or by a decree of a Court of Law and /or that the corner points mentioned in lines 3, 4 and 5 above were in conformance with the rules of the Michigan Board of Land Surveyors or by a Decree of a Court of Law, established, re-established, monumented, recovered, found as expressed below:

NOTE: Not more than 2 corners, all in the same town and range, may be recorded on this certificate.

A. Description of original monument and accessories and/or subsequent restoration:

I-9 Corner Common to Sections 22, 23, 26, & 27, T46N, R7W

1850 - Original corner established by Wells Burt, a cedar post.
 Witnesses: Tamarack 10, S15°W 29 links - Tamarack 12, N21°E 21 links

Found no evidence of subsequent restoration of this corner.


B. Description of corner evidence found and/or method applied in restoring or reestablishing corner:

This corner is being reestablished as part of the Chippewa County Remonumentation Program. Found no evidence of the original cedar post. Reestablished corner at the intersection of lines from found blazes in a large cedar and a tamarack. The distance to the ¼ corner I-10 to the south is within 1 foot of the original GLO distance. The east-west position is within 5 feet of a pro-rated GLO distance between the ¼ corner at H-9, ½ mile to the west and the section corner at M-9 on the range line, 2 miles to the east.

C. Description of monument for corner and accessories established to perpetuate locating the position of the corner:

Placed a ¾" x 24" rebar with a stamped aluminum Chippewa County Remonumentation cap at the corner location.
 Witnesses:
 Nail and tag #33142 in southerly twin 8" blazed Tamarack, N71°W 17.38'
 Nail and tag #33142 in 14" blazed Tamarack, N45°W 61.53'
 Nail and tag #33142 in 12" blazed Tamarack, N10°W 15.26'
 Nail and tag #33142 in 14" blazed Tamarack, S01°E 14.71'

A	B	C	D	E	F	G	H	I	J	K	L	M
1												
2	6	5	4	3	2	1						
3												
4	7	8	9	10	11	12						
5												
6	18	17	16	15	14	13						
7												
8	19	20	21	22	23	24						
9												
10	30	29	28	27	26	25						
11												
12	31	32	33	34	35	36						
13												

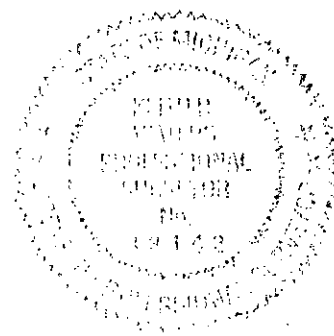

Signed by Keith R. Waters

Date 12-29-99

Surveyor's Michigan License No. 33142