

**LAND CORNER RECORDATION CERTIFICATE**  
**Filing Requirement of Act 74, Mich. P.A. 1970**  
**Chippewa County Remonumentation Corner**

For corners in SECTION

Chippewa County	Located in:	Corner Code #
1. Public Land Survey	T46N R7W	I-10
	T R	
	T R	
	T R	
2. Property Controlling in Section	S T R	
	S T R	
3. Miscellaneous Property in Sec.	S T R	
	S T R	

BOOK **11** PAGE **109**

\$7.00 LAND CORNER  
 \$2.00 NSSR  
 23 FEB 2000 4:32:05 PM Receipt #21179  
 RECEIVED FOR RECORD  
 CHIPPEWA COUNTY - STATE OF MICHIGAN  
 SHARON H. KENNEDY, REGISTER OF DEEDS

Register of Deeds Stamp & File Number

4. Lot No. , Recorded Plat  
 5. Private Claims

I, Keith R. Waters, in a field survey on November 3, 1999, do hereby state that under requirements of P.A. 74, Michigan P.A. of 1970, the corner points mentioned in lines 1 and 2 above were in conformance with regulations and rules therefore as required in the current manual of survey instructions of the United States Department of the Interior, Bureau of Land Management or by a decree of a Court of Law and /or that the corner points mentioned in lines 3, 4 and 5 above were in conformance with the rules of the Michigan Board of Land Surveyors or by a Decree of a Court of Law; established, re-established, monumented, recovered, found as expressed below:

NOTE: Not more than 2 corners, all in the same town and range, may be recorded on this certificate.

A	B	C	D	E	F	G	H	I	J	K	L	M
1												
2	6	5	4	3	2	1						
3												
4	7	8	9	10	11	12						
5												
6	18	17	16	15	14	13						
7												
8	19	20	21	22	23	24						
9												
10	30	29	28	27	26	25						
11												
12	31	32	33	34	35	36						
13												

A. Description of original monument and accessories and/or subsequent restoration:

I-10 1/4 Corner Common to Sections 26 & 27, T46N, R7W

1850 - Original corner established by Wells Burt, a cedar post.  
 Witnesses: Cedar 12, S18°E 09 links - Yellow Birch 18, N29°E 25 links.

1910 - Frederick H. Brown, R.L.S. 944, Plat of Hulbert's Subdivision, as recorded in Liber 3 of Plats, Page 38, Chippewa County Records. Quarter post is shown on the westerly boundary of said plat, midway between the northwest and southwest corners thereof (330 feet each way).

1919 - Chippewa County Surveyor notes reference an original corner at this location.

1922 - Chippewa County Surveyor notes again reference an original corner, bearing trees standing.




B. Description of corner evidence found and/or method applied in restoring or reestablishing corner:

This corner is being reestablished as part of the Chippewa County Remonumentation Program. Found no evidence of the original corner. Reestablished corner 330 feet south of the northwest corner of the Plat of Hulbert's Subdivision, on line with the section corner at I-11 to the south. This east-west position also works well with other found monumentation in the interior of said Subdivision. Corner falls in the approximate centerline of Hulbert Road.

C. Description of monument for corner and accessories established to perpetuate locating the position of the corner:

Placed a 3/4" x 24" rebar with a stamped aluminum Chippewa County Remonumentation cap in a monument box at the corner location, which falls in the approximate centerline of an east-west bituminous road (Hulbert Road), at the intersection of a gravel road (Spruce Street) to the south.

- Witnesses:  
 Nail and tag #33142 in Power Pole (EK4/163), N40°W 41.75'  
 Nail and tag #33142 in Power Pole (EK4/164A), S80°W 133.73'  
 Nail and tag #33142 in Power Pole (EK4/163), S06°W 286.52'  
 Nail and tag #33142 in Power Pole, S64°E 120.15'

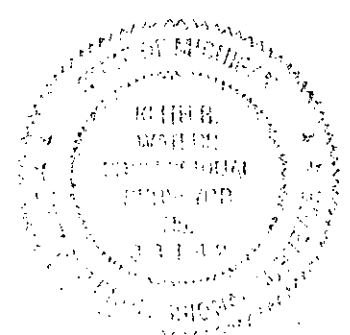

Signed by Keith R. Waters

Date 12-29-99

Surveyor's Michigan License No. 33142