

LAND CORNER RECORDATION CERTIFICATE
Filing Requirement of Act 74, Mich. P.A. 1970
Chippewa County Remonumentation Corner

SECTION

For corners in

Chippewa County	Located in:	Corner Code #
1. Public Land Survey	T46N R7W	I-11
	T R	
	T R	
	T R	
2. Property Controlling in Section	S T R	
	S T R	
3. Miscellaneous Property in Sec.	S T R	
	S T R	
4. Lot No. , Recorded Plat		
5. Private Claims		

BOOK **11** PAGE **110**

\$7.00 LAND CORNER
 \$2.00 MSSR
 23 FEB 2000 4:32:58 PM Receipt #21179
 RECEIVED FOR RECORD
 CHIPPEWA COUNTY - STATE OF MICHIGAN
 SHARON H. KENNEDY, REGISTER OF DEEDS

Register of Deeds Stamp & File Number

	A	B	C	D	E	F	G	H	I	J	K	L	M
1													
2	6		5		4		3		2		1		
3													
4	7		8		9		10		11		12		
5													
6	18		17		16		15		14		13		
7													
8	19		20		21		22		23		24		
9													
10	30		29		28		27		26		25		
11													
12	31		32		33		34		35		36		
13													

I, Keith R. Waters, in a field survey on December 6, 1999, do hereby state that under requirements of P.A. 74, Michigan P.A. of 1970, the corner points mentioned in lines 1 and 2 above were in conformance with regulations and rules therefore as required in the current manual of survey instructions of the United States Department of the Interior, Bureau of Land Management or by a decree of a Court of Law and /or that the corner points mentioned in lines 3, 4 and 5 above were in conformance with the rules of the Michigan Board of Land Surveyors or by a Decree of a Court of Law; established, re-established, monumented, recovered, found as expressed below:

NOTE: Not more than 2 corners, all in the same town and range, may be recorded on this certificate.

A. Description of original monument and accessories and/or subsequent restoration:

I-11 Corner Common to Sections 26, 27, 34, & 35, T46N, R7W

1850 – Original corner established by Wells Burt, a beech post.
 Witnesses: Beech 10, S30°E 13 links – Sugar 12, N25°W 44 links.

1922 – Chippewa County Surveyor notes indicate that this "corner is gone."

1927 – Alford H. Colwell, Plat of Hulbert Township Cemetery, as recorded in Liber 4 of Plats, Page 39, Chippewa County Records. Point of beginning of Plat is shown 33 feet west and 33 feet north of section corner.


B. Description of corner evidence found and/or method applied in restoring or reestablishing corner:

This corner is being perpetuated as part of the Chippewa County Remonumentation Program. Found a well point, which fits with found concrete monuments in the above mentioned Plat of Hulbert Township Cemetery. Accepted corner location as found and replaced the found well point with a 4" diameter concrete monument.

C. Description of monument for corner and accessories established to perpetuate locating the position of the corner:

Placed a 4" diameter concrete monument with a 1/2" rebar and cap #33142 at corner location, replacing a found well point. Corner falls on the west side of a north-south 2 track road, south and east of the southeast corner of the Hulbert Township Cemetery.

Witnesses:
 Nail and tag #33142 in 4" Sugar Maple, N20°W 23.31'
 Nail and tag #33142 in 14" Beech, EAST 23.85'
 Nail and tag #33142 in easterly tree of twin 14" Yellow Birch, S12°W 11.76'
 Nail and tag #33142 in northerly tree of triple 12" Beech, S80°W 9.27'
 Center of post at southerly end of 4' high Chain Link Fence, N46°W 45.09'
 4" diameter Concrete Monument (stamped "121"), N30°W 60.08'
 (northeast corner of Cemetery Lot #1)

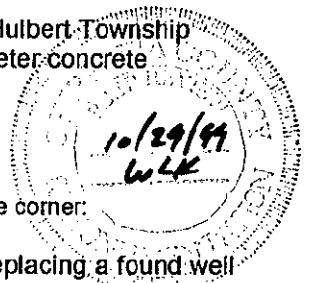

Signed by Keith R. Waters

Date 12-29-99

Surveyor's Michigan License No. 33142