

**LAND CORNER RECORDATION CERTIFICATE**  
**Filing Requirement of Act 74, Mich. P.A. 1970**  
**Chippewa County Remonumentation Corner**

For corners in SECTION

BOOK **11** PAGE **111**

Chippewa County	Located in:	Corner Code #
1. Public Land Survey	T46N R7W	I-12
	T R	
	T R	
	T R	
2. Property Controlling in Section	S T R	
	S T R	
3. Miscellaneous Property in Sec.	S T R	
	S T R	
4. Lot No. , Recorded Plat		
5. Private Claims		

\$7.00 LAND CORNER  
 \$2.00 MSSR  
 23 FEB 2000 4:33:53 PM Receipt #21179  
 RECEIVED FOR RECORD  
 CHIPPEWA COUNTY - STATE OF MICHIGAN  
 SHARON H. KENNEDY, REGISTER OF DEEDS

Register of Deeds Stamp & File Number

I, Keith R. Waters, in a field survey on September 9, 1999, do hereby state that under requirements of P.A. 74, Michigan P.A. of 1970, the corner points mentioned in lines 1 and 2 above were in conformance with regulations and rules therefore as required in the current manual of survey instructions of the United States Department of the Interior, Bureau of Land Management or by a decree of a Court of Law and /or that the corner points mentioned in lines 3, 4 and 5 above were in conformance with the rules of the Michigan Board of Land Surveyors or by a Decree of a Court of Law; established, re-established, monumented, recovered, found as expressed below:


NOTE: Not more than 2 corners, all in the same town and range, may be recorded on this certificate.

A	B	C	D	E	F	G	H	I	J	K	L	M
1												
2	6	5	4	3	2	1						
3												
4	7	8	9	10	11	12						
5												
6	18	17	16	15	14	13						
7												
8	19	20	21	22	23	24						
9												
10	30	29	28	27	26	25						
11												
12	31	32	33	34	35	36						
13												

A. Description of original monument and accessories and/or subsequent restoration:

I-12 ¼ Corner Common to Sections 34 & 35, T46N, R7W

- 1850 – Original corner established by Wells Burt, a cedar post.  
 Witnesses: White Pine 10, S74°E 20 links – White Pine 12, S26°W 22 links.
- 1990 – Gerald L. Wiggins, P.S. 23521, LCRC recorded in Liber 7, Page 243, Chippewa County Corner Records.  
 Corner set at a very old wood post and two original bearing trees, a white pine stump S26°W 22 links and a living 24" white pine S74°E 20 links. New witnesses to set DNR monument:  
 12" Cedar, S31°E 20.05'  
 6" Cedar, S68°W 9.30'  
 8" Cedar, N20°W 6.90'  
 24" White Pine, S74°E 13.20'

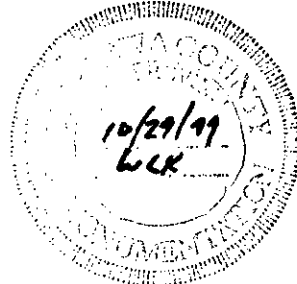


B. Description of corner evidence found and/or method applied in restoring or reestablishing corner:

This corner is being perpetuated as part of the Chippewa County Remonumentation Program. Found an iron pipe with a stamped aluminum Department of Natural Resources cap and all record bearing trees as called for in the above mentioned 1990 LCRC. The stump of the original white pine bearing tree S26°W 22 links is also still standing.

C. Description of monument for corner and accessories established to perpetuate locating the position of the corner:

Found an iron pipe with a stamped Department of Natural Resources cap next to a square wood post at the corner location. Witnesses:  
 12" Cedar, S31°E 20.05'  
 6" Cedar, S68°W 9.30'  
 8" Cedar, N20°W 6.90'  
 24" White Pine, S74°E 13.20' (original bearing tree)

Note: All trees are blazed and scribed.

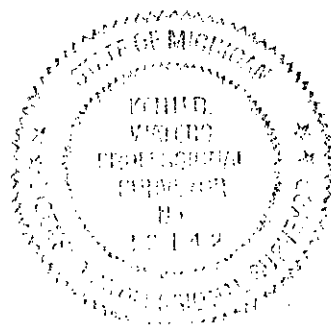

Signed by Keith R. Waters

Date 12-29-99

Surveyor's Michigan License No. 33142