

**LAND CORNER RECORDATION CERTIFICATE**  
**Filing Requirement of Act 74, Mich. P.A. 1970**  
**Chippewa County Remonumentation Corner**

SECTION

For corners in

BOOK **11** PAGE **117**

Chippewa County	Located in:	Corner Code #
1. Public Land Survey	T46N R7W	K-10
	T R	
	T R	
	T R	
2. Property Controlling in Section	S T R	
	S T R	
3. Miscellaneous Property in Sec.	S T R	
	S T R	
4. Lot No. , Recorded Plat		
5. Private Claims		

47.00 LAND CORNER  
 42.00 MSSR  
 23 FEB 2000 4:37:59 PM Receipt #21179  
 RECEIVED FOR RECORD  
 CHIPPEWA COUNTY - STATE OF MICHIGAN  
 SHARON H. KENNEDY, REGISTER OF DEEDS

Register of Deeds Stamp & File Number

A	B	C	D	E	F	G	H	I	J	K	L	M
1												
2	6	5	4	3	2	1						
3												
4	7	8	9	10	11	12						
5												
6	18	17	16	15	14	13						
7												
8	19	20	21	22	23	24						
9												
10	30	29	28	27	26	25						
11												
12	31	32	33	34	35	36						
13												

I, Keith R. Waters, in a field survey on November 9, 1999, do hereby state that under requirements of P.A. 74, Michigan P.A. of 1970, the corner points mentioned in lines 1 and 2 above were in conformance with regulations and rules therefore as required in the current manual of survey instructions of the United States Department of the Interior, Bureau of Land Management or by a decree of a Court of Law and /or that the corner points mentioned in lines 3, 4 and 5 above were in conformance with the rules of the Michigan Board of Land Surveyors or by a Decree of a Court of Law; established, re-established, monumented, recovered, found as expressed below:

NOTE: Not more than 2 corners, all in the same town and range, may be recorded on this certificate.

A. Description of original monument and accessories and/or subsequent restoration:


K-10 1/4 Corner Common to Section 25 & 26, T46N, R7W

1850 - Original corner established by Wells Burt, a cedar post.  
 Witnesses: Cedar 12, S76°E 07 links - Cedar 13, N50°W 28 links.

1922 - Chippewa County Surveyor's notes indicate setting this 1/4 post 2640 feet north of an original section corner at K-11 to the south.

B. Description of corner evidence found and/or method applied in restoring or reestablishing corner:

This corner is being reestablished as part of the Chippewa County Remonumentation Program. Found no evidence of the original corner. Reestablished corner by single proportionate measurement midway on line between section corners 2640.1 feet to the north and 2640.1 feet to the south.

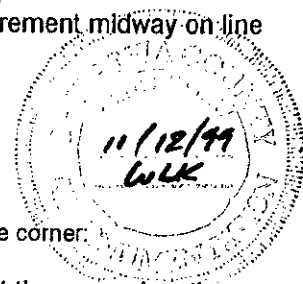

C. Description of monument for corner and accessories established to perpetuate locating the position of the corner:

Placed a 3/4" x 24" rebar with a stamped aluminum Chippewa County Remonumentation cap at the corner location, which falls approximately 370 feet south of the old Soo Line Railroad grade.

Witnesses:  
 Nail and tag #33142 in 7" blazed White Birch, SOUTH 41.39'  
 Nail and tag #33142 in 6" blazed White Birch, EAST 13.53'  
 Nail and tag #33142 in 6" blazed Black Spruce, N08°E 33.13'  
 Nail and tag #33142 in 5" blazed Balsam Fir, N87°W 50.72'



Signed by Keith R. Waters

Date 12-29-99

Surveyor's Michigan License No. 33142