

LAND CORNER RECORDATION CERTIFICATE
Filing Requirement of Act 74, Mich. P.A. 1970
Chippewa County Remonumentation Corner

For corners in SECTION

BOOK **11** PAGE **119**

Chippewa County	Located in:	Corner Code #
1. Public Land Survey	T46N R7W	K-12
	T R	
	T R	
	T R	
2. Property Controlling in Section	S T R	
	S T R	
3. Miscellaneous Property in Sec.	S T R	
	S T R	
4. Lot No.	, Recorded Plat	
5. Private Claims		

\$7.00 LAND CORNER
 \$2.00 MSSR
 23 FEB 2000 4:39:17 PM Receipt #21179
 RECEIVED FOR RECORD
 CHIPPEWA COUNTY - STATE OF MICHIGAN
 SHARON H. KENNEDY, REGISTER OF DEEDS

Register of Deeds Stamp & File Number

I, Keith R. Waters, in a field survey on June 30, 1999, do hereby state that under requirements of P.A. 74, Michigan P.A. of 1970, the corner points mentioned in lines 1 and 2 above were in conformance with regulations and rules therefore as required in the current manual of survey instructions of the United States Department of the Interior, Bureau of Land Management or by a decree of a Court of Law and /or that the corner points mentioned in lines 3, 4 and 5 above were in conformance with the rules of the Michigan Board of Land Surveyors or by a Decree of a Court of Law; established, re-established, monumented, recovered, found as expressed below:

NOTE: Not more than 2 corners, all in the same town and range, may be recorded on this certificate.

A. Description of original monument and accessories and/or subsequent restoration:

K-12 1/4 Corner Common to Sections 35 & 36, T46N, R7W

1850 - Original corner established by Wells Burt, a beech post.
 Witnesses: Beech 10, S51°W 35 links - Beech 7, N61°E 38 links.

1917 - Chippewa County Surveyor's notes indicate an original corner at this position.
 Witnesses: Yellow Birch, 24' West and 5' South - Maple 14, 9' South and 5' East (had no compass).

1968 - Eino Sainio, P.S. 7873, sketch of the south 1/2 of Section 36, shows an iron pipe at this corner, with a distance of 5309 feet between the east and west 1/4 corners of said section.

B. Description of corner evidence found and/or method applied in restoring or reestablishing corner:


This corner is being perpetuated as part of the Chippewa County Remonumentation Program. Found a 1 1/4" iron pipe at the base of a fallen down wood post, in the proper position in relation to a possible original bearing tree, a 30" beech. The original bearing tree was a 7" beech, N61°E 38 links. The distance between the east and west 1/4 corners of Section 36 checks reasonably well (5309 feet record, 5302 feet measured) with the above mentioned 1968 sketch. Accepted corner as found and established new bearing trees.

C. Description of monument for corner and accessories established to perpetuate locating the position of the corner:

Found a 1 1/4" iron pipe at the base of a fallen wood post at the corner location. Placed a stamped aluminum Chippewa County Remonumentation cap in the top of the found pipe.

Witnesses:
 Nail and tag #33142 in 8" blazed Beech, N59°E 36.36'
 Nail and tag #33142 in 7" blazed Yellow Birch, S44°E 36.22'
 Nail and tag #33142 in 8" blazed Beech in clump, S20°W 32.10'
 Nail and tag #33142 in 7" blazed Hemlock, N64°W 37.69'

A	B	C	D	E	F	G	H	I	J	K	L	M
1												
2	6		5		4		3		2		1	
3												
4	7		8		9		10		11		12	
5												
6	18		17		16		15		14		13	
7												
8	19		20		21		22		23		24	
9												
10	30		29		28		27		26		25	
11												
12	31		32		33		34		35		36	
13												

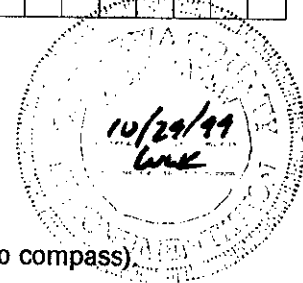

Signed by Keith R. Waters

Date 12-29-99

Surveyor's Michigan License No. 33142