LAND CORNER RECORDATION CERTIFICATE Filing Requirement of Act 74, Mich. P.A. 1970

Chippewa County Remonumentation Corner 11 PAGE 120

For corners in

E-CONTROL

Corner Code # Chippewa County Located in: **T46N R7W** K-13 1. Public Land Survey **)** Same **T45N R7W** Corner Т R R T STATE OF MICHES T R 2. Property Controlling S r re<sup>tt</sup> R <sub>z</sub>ret R T in Section S 3. Miscellaneous S Т WAHES Property in Sec. DESCRIPTION <u>.</u> ' 1 S1894 : OB 4. Lot No. , Recorded Plat Ptc. 5. Private Claims 3 1 4 20175810NP


\$7.00 LAND CORNER \$2.00 MSSR Receipt #21179 23 FEB 2000 4:40:07 PK RECEIVED FOR RECORD CHIPPENA COUNTY - STATE OF MICHIGAN SHARON H. KENNEDY, REGISTER OF DEEDS

Register of Deeds Stamp & File Number

I, Keith R. Waters, in a field survey on December 14, 1999, do hereby state that under requirements of P.A. 74, Michigan P.A. of 1970, the corner points mentioned in lines 1 and 2 above were in conformance with regulations and rules therefore as required in the current manual of survey instructions of the United States Department of the Interior, Bureau of Land Management or by a decree of a Court of Law and for that the corner points mentioned in lines 3, 4 and 5 above were in conformance with the rules of the Michigan Board of Land Surveyors or by a Decree of a Court of Law; established, re-established, monumented, recovered, found as expressed below:

NOTE: Not more than 2 corners, all in the same town and range, may be recorded on this certificate.

A. Description of original monument and accessories and/or subsequent restoration:

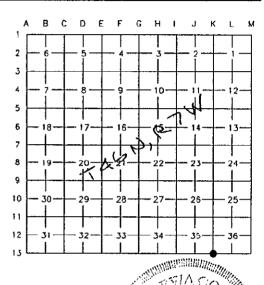

NOW IN

## K-13 (K-1) Comer Common to Sections 1 & 2, T45N, R7W & Sections 35 & 36, T46N, R7W

- 1840 Original corner established by Austin Burt. Witnesses: Beech 8, N62°E 12 links - Beech 14, N30°W 20 links.
- 1850 Witnesses added by Wells Burt during the subdivision of Town 45 North, Range 7 West: Beech 8, S60°W 25 links - Maple 6, S611/2°E 13 links.
- 1936 GLO Dependent Resurvey of T46N, R6W. Notes indicate "there is no remaining evidence of the corner of Sections 1, 2, 35, and 36, T46N, R7W." A line was run from the township corner at M-13 to the original 1/4 comer at J-13.
- B. Description of corner evidence found and/or method applied in restoring or reestablishing corner:

This corner is being reestablished as part of the Chippewa County Remonumentation Program. Found no evidence of the original corner. Reestablished comer by single proportionate measurement on the township line between recovered corners at M-13 and J-13.


C. Description of monument for corner and accessories established to perpetuate locating the position of the corner:

Set a "Mag Nail" at the corner location, which falls in the eastbound lane of Highway M-28, 3.3 feet south of the existing centerline. Also established reference monuments as shown in sketch below.

Witnesses to "Mag Nail":

12" Sugar Maple, S51°41'26"E 65.78' Power Pole, N58°32'25"W 76.33' 18" Sugar Maple, N31°20'31"W 53.92' 12" Sugar Maple, N34°39'00"E 57.52'

Note: Bearings and distances are from the section corner to the head of a nail and tag #33142 in the side of the witness object. Bearings are in relation to the sketch to right.

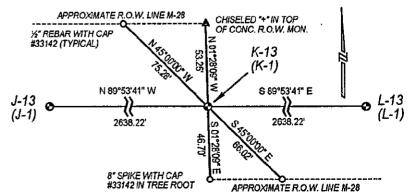

Keith R. Water

12-29-99 Date

Surveyor's Michigan License No. 33142

FORM APPROVED BY MICHIGAN STATE BOARD OF PROFESSIONAL SURVEYORS, JAN. 28, 1971

REVISED MAY 14, 1975
REVISED JAN., 1983
REVISED OCT., 1995

T46N R7W K-13