

SURVEY & REMONUMENTATION

CHIPPEWA COUNTY REMONUMENTATION CORNER CHIPPEWA COUNTY STATE OF MICHIGAN

1993

LAND CORNER RECORDATION CERTIFICATE
Filing Requirement of Act 74, Mich. P.A. 1970

93 DEC -3 PM 3: 59


For corners in **COMMISSION**
Chippewa

J. Roger Malott
REGISTER OF DEEDS

	Located In:	Corner Code #
1. Public Land Survey	T 46N R 1E T 46N R 1W T _____ R _____ T _____ R _____	A-3 Same M-3 Corner
2. Property Controlling in Section	S _____ T _____ R _____ S _____ T _____ R _____	_____
3. Miscellaneous Property in Sec.	S _____ T _____ R _____ S _____ T _____ R _____	_____
4. Lot No. _____, Recorded Plat _____		
5. Private Claims _____		

Register of Deeds Stamp & File Number


I, **Keith R. Waters** in a field survey on **August 31**, 19 **93**, do hereby certify that under requirements of P.A. 74, Michigan P.A. of 1970, the corner points mentioned in lines 1 and 2 above were in conformance with regulations and rules therefore as required in the current manual of survey instructions of the United States Department of the Interior, Bureau of Land Management or by a decree of a Court of Law and/or that the corner points mentioned in lines 3, 4 and 5 above were in conformance with the rules of the Michigan Board of Land Surveyors or by a Decree of a Court of Law, established, re-established, monumented, re-monumented, recovered, found as expressed below:

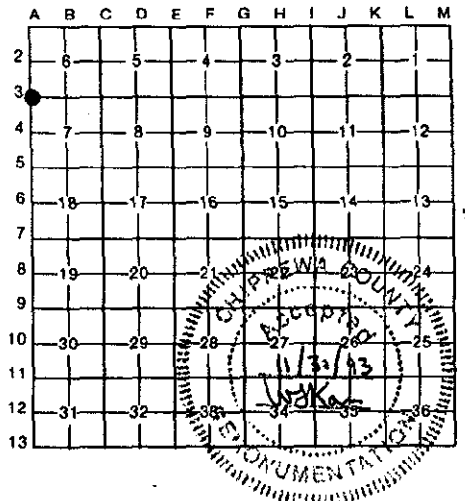

NOTE: Not more than 4 corners, all in the same town and range, may be recorded on this certificate.

A. Description of original monument and accessories and/or subsequent restoration:
A-3 (T46N, R1E)
 Section Corner Common to Sections 6 & 7, T46N, R1E & Sections 1 & 12, T46N, R1W.
 (1986)
 This corner is recorded by Larry R. Rogers, P.S. 29251, in liber 6, page 291, of Chippewa County corner records as a 3/4" iron with the following ties:
 Corner Fence Post, N25°E 32.66' Power Pole, S65°E 136.00'
 Corner Fence Post, S14°E 31.11' Corner Fence Post, S53°W 40.70'

B. Description of corner evidence found and/or method applied in restoring or reestablishing corner:
A-3 (T46N, R1E)
 This corner is being perpetuated as part of the Chippewa County Remonumentation Program.
 Found a 3/4" iron pin approximately 2 feet north of centerline of east-west gravel road (7 Mile Road). Position checks with two remaining witnesses from 1986 records (power pole and northerly fence post). Fence posts on the south side of the road have been replaced. Accepted corner as found and established new witness objects.

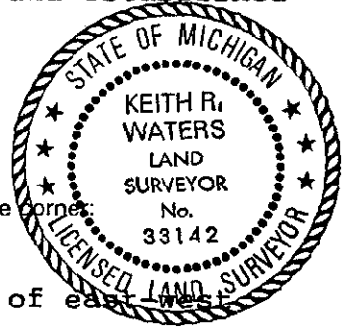

C. Description of monument for corner and accessories established to perpetuate locating the position of the corner:
A-3 (T46N, R1E)
 Corner is a 3/4" iron pin approximately 2' north of centerline of east-west gravel road (7 Mile Road). Witnesses:
 Power Pole, S65°E 136.00'
 Gate Post, S02°W 37.93'
 Corner Fence Post, S41°W 49.97'
 5" Elm, S82°W 236.93'
 Corner Fence Post, N25°E 32.66'

Note: Distances are to a nail and tag in the side of witness object. Bearings are compass bearings corrected for declination. Distances are measured with EDM. Elm is blazed and painted.

Signed by Keith R. Waters Date 11-30-93
 Surveyor's Michigan License No. 33142