

RECEIVED FOR RECORD
CHIPPEWA COUNTY
STATE OF MICHIGAN

93 DEC -3 PM 3:59

COMMISSION LAND CORNER RECORDATION CERTIFICATE
Filing Requirement of Act 74, Mich. P.A. 1970

J. Roger Malott
REGISTER OF DEEDS

For corners in
Chippewa

(County)	Located In:	Corner Code #/
1. Public Land Survey	T46N R 1E T46N R 1W T _____ R _____ T _____ R _____	A-8 Same M-8 Corner
2. Property Controlling in Section	S _____ T _____ R _____ S _____ T _____ R _____	_____
3. Miscellaneous Property in Sec.	S _____ T _____ R _____ - S _____ T _____ R _____	_____
4. Lot No. _____, Recorded Plat _____		
5. Private Claims _____		

Register of Deeds Stamp & File Number

I, Keith R. Waters in a field survey on June 3, 1993, do hereby certify that under requirements of P.A. 74, Michigan P.A. of 1970, the corner points mentioned in lines 1 and 2 above were in conformance with regulations and rules therefore as required in the current manual of survey instructions of the United States Department of the Interior, Bureau of Land Management or by a decree of a Court of Law and/or that the corner points mentioned in lines 3, 4 and 5 above were in conformance with the rules of the Michigan Board of Land Surveyors or by a Decree of a Court of Law; established, re-established, monumented, re-monumented, recovered, found as expressed below:

NOTE: Not more than 4 corners, all in the same town and range, may be recorded on this certificate.

A. Description of original monument and accessories and/or subsequent restoration:

A-8 (T46N, R1E)
1/4 Corner Common to Section 19, T46N, R1E & Section 24, T46N, R1W

Corner recorded by Larry R. Rogers, P.S. 29251, in liber 6, page 283, of Chippewa County corner records (12-3-1983), as a 1 1/4" iron bar with a 1 3/4" round top with the following ties:

- Power Pole, N18°E 96.78'
- 10" Larch, S70°E 86.91'
- Corner Fence Post, S88°W 34.29'

B. Description of corner evidence found and/or method applied in restoring or reestablishing corner:

A-8 (T46N, R1E)
This corner is being perpetuated as part of the Chippewa County Remonumentation Program.
Found a 1 1/4" iron bar with a 1 3/4" round top in the centerline of north-south dirt road. Power pole and 10" larch with PK nails in the sides are intact and check well with 1983 records. Corner fence post has been removed due to new fence construction. Accepted corner as found and established new witness objects.


C. Description of monument for corner and accessories established to perpetuate locating the position of the corner:

A-8 (T46N, R1E)
Corner is a 1 1/4" iron bar with a 1 3/4" round top in the centerline of north-south dirt road. Witnesses:

- Power Pole, N18°E 96.74'
- 10" Larch, S70°E 86.86'
- Corner Fence Post, S88°W 33.88'
- Fence Post, N30°W 59.16'
- (Second post north of corner)

Note: Distances to pole and larch are to a PK nail in the side. Distances to fence posts are to a nail and tag in the side. Distances measured with EDM. Bearings are compass bearings corrected for declination. Larch is blazed and painted.

A	B	C	D	E	F	G	H	I	J	K	L	M
2	6	5	4	3	2							
3												
4	7	8	9	10	11	12						
5												
6	18	17	16	15	14	13						
7												
8	19	20	21	22	23	24						
9												
10	30	29	28									
11												
12	31	32	33	34	35	36						
13												

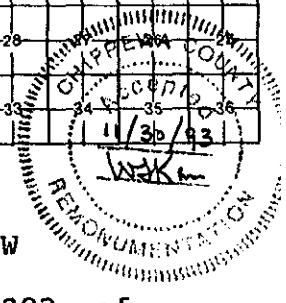

Signed by Keith R. Waters Date 11-30-93
Surveyor's Michigan License No. 33142