

1893

LAND CORNER RECORDATION CERTIFICATE  
Filing Requirement of Act 74, Mich. P.A. 1970

93 DEC -3 PM 3: 58

COMMISSION

For corners in  
Chippewa

(County)	Located In:	Corner Code #
1. Public Land Survey	T 45N R 1E T 45N R 1W T 46N R 1E T 46N R 1W	A-1 Same M-1 Corner A-13 (Twp. M-13 Corner)
2. Property Controlling in Section	S ___ T ___ R ___ S ___ T ___ R ___	
3. Miscellaneous Property In Sec.	S ___ T ___ R ___ S ___ T ___ R ___	

*J. Roger Madole*  
REGISTER OF DEEDS

Register of Deeds Stamp & File Number

4. Lot No. \_\_\_\_\_, Recorded Plat \_\_\_\_\_  
5. Private Claims \_\_\_\_\_

I, Keith R. Waters in a field survey on June 2, 19 93

do hereby certify that under requirements of P.A. 74, Michigan P.A. of 1970, the corner points mentioned in lines 1 and 2 above were in conformance with regulations and rules therefore as required in the current manual of survey instructions of the United States Department of the Interior, Bureau of Land Management or by a decree of a Court of Law and/or that the corner points mentioned in lines 3, 4 and 5 above were in conformance with the rules of the Michigan Board of Land Surveyors or by a Decree of a Court of Law; established, re-established, monumented, re-monumented, recovered, found as expressed below:

NOTE: Not more than 4 corners, all in the same town and range, may be recorded on this certificate.

A. Description of original monument and accessories and/or subsequent restoration:

A-1 (T45N, R1E)

Township Corner Common to T45N, R1E & T45N, R1W & T46N, R1E & T46N, R1W

Michigan State Highway Department (11-29-65) as recorded in liber 3, page 237 of Chippewa County corner records: Found a 3/4" iron pin in monument box with the following ties: Mail Box, S85°W 67.62'  
Mail Box, N25°W 38.00'  
Power Pole, S70°E 76.91'

B. Description of corner evidence found and/or method applied in restoring or reestablishing corner:

A-1 (T45N, R1E)

This corner is being perpetuated as part of the Chippewa County Remonumentation Program.

Found a 1/2" iron pin in a monument box in centerline of Highway M-129 at the intersection of 12 Mile Road east and west. All witnesses from 1965 Highway Department records are gone. Distances as shown by Highway Department to corners 1 mile north and 1 mile south match closely with measured distances. Accepted corner location as found and established four new witness objects.

C. Description of monument for corner and accessories established to perpetuate locating the position of the corner:


A-1 (T45N, R1E)

Corner is a 1/2" iron pin in a monument box in centerline of Highway M-129 at the intersection of 12 Mile Road.

Witnesses:

- 12" Spruce, N21°E 208.39'
- 6" Spruce, N78°E 176.85'
- Power Pole (DR2-91), S17°E 209.07'
- MBT Pole (324), N33°W 144.76'

Note: All distances are to a nail and tag in the side of the witness object. Bearings are compass bearings corrected for declination. Trees were not blazed due to the proximity of occupied houses.

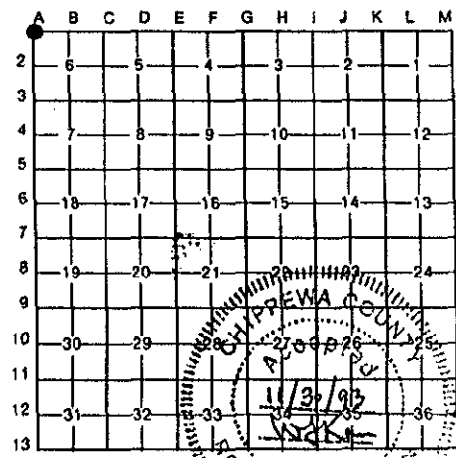

Signed by Keith R. Waters Date 11-30-93

Surveyor's Michigan License No. 33142