

**SURVEY &  
REMONUMENTATION**

**Chippewa County Remonumentation Corner**

RECEIVED FOR RECORD  
CHIPPEWA COUNTY  
STATE OF MICHIGAN

MAR 09 1994

**LAND CORNER RECORDATION CERTIFICATE  
Filing Requirement of Act 74, Mich. P.A. 1970**

93 DEC 14 PM 4: 26

For corners in  
**Chippewa** **COMMISSION**  
(County)

Located In: Corner Code #

- |                                       |   |            |   |           |            |       |
|---------------------------------------|---|------------|---|-----------|------------|-------|
| 1. Public Land Survey                 | T | <u>46N</u> | R | <u>1E</u> | <u>B-3</u> |       |
|                                       | T | _____      | R | _____     | _____      |       |
|                                       | T | _____      | R | _____     | _____      |       |
|                                       | T | _____      | R | _____     | _____      |       |
| 2. Property Controlling<br>in Section | S | _____      | T | _____     | R          | _____ |
|                                       | S | _____      | T | _____     | R          | _____ |
| 3. Miscellaneous<br>Property in Sec.  | S | _____      | T | _____     | R          | _____ |
|                                       | S | _____      | T | _____     | R          | _____ |
4. Lot No. \_\_\_\_\_, Recorded Plat \_\_\_\_\_
5. Private Claims \_\_\_\_\_

*J. Roger Malotte*  
REGISTER OF DEEDS

Register of Deeds Stamp & File Number

I, William L. Karr, in a field survey on November 22, 19 93,

do hereby certify that under requirements of P.A. 74, Michigan P.A. of 1970, the corner points mentioned in lines 1 and 2 above were in conformance with regulations and rules therefore as required in the current manual of survey instructions of the United States Department of the Interior, Bureau of Land Management or by a decree of a Court of Law and/or that the corner points mentioned in lines 3, 4 and 5 above were in conformance with the rules of the Michigan Board of Land Surveyors or by a Decree of a Court of Law; established, re-established, monumented, re-monumented, recovered, found as expressed below:

**NOTE: Not more than 4 corners, all in the same town and range, may be recorded on this certificate.**

A. Description of original monument and accessories and/or subsequent restoration:

(B-3) 1/4 Corner Common to Sections 6 & 7, (T46N-R1E)

This corner was previously recorded by W.L. Karr, L.S. 27450 in Liber 7, Page 316 of the Chippewa County Corner Records as a 1" square bolt in a monument box with the following witnesses:

Drill hole in concrete headwall	N67°E	44.80'
Power Pole DR3/90	S53°W	93.52'
Drill hole in concrete headwall	N68°W	44.17'

B. Description of corner evidence found and/or method applied in restoring or reestablishing corner:



(B-3) This corner is being perpetuated as part of the Chippewa County Remonumentation Program.

Found 1" square bolt with witnesses as called for. Accepted corner position as found and added one new witness.

C. Description of monument for corner and accessories established to perpetuate locating the position of the corner:

(B-3) Corner is a 1" square bolt in monument box. Falls on intersecting centerlines on M-129 and Seven Mile Road.

Witnesses: Drill hole in concrete headwall	N67°E	44.80'
Power Pole DR3/90	S53°W	93.44'
Drill hole in concrete headwall	N68°W	44.17'
Drill hole in concrete headwall	S60°E	44.53'

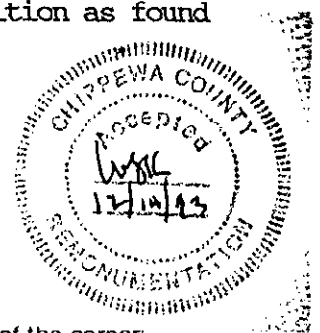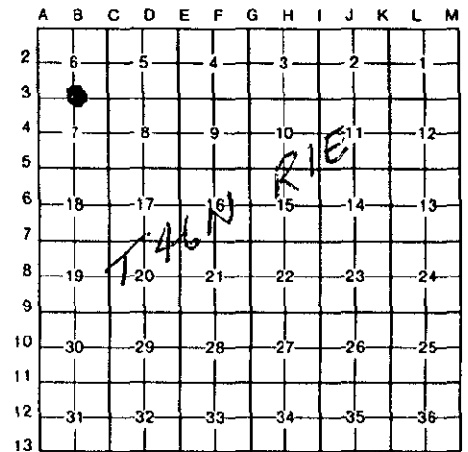

Signed by William L. Karr Date 12/14/93

Surveyor's Michigan License No. 27450

NOTE: Bearings are compass bearings corrected for declination. Distances are to a nail in side of witness objects unless noted.