

1993

Chippewa County Remonumentation Corner

COMMISSION

LAND CORNER RECORDATION CERTIFICATE

Filing Requirement of Act 74, Mich. P.A. 1970

For corners in

Chippewa
(County)

Located In:

Corner Code #

- 1. Public Land Survey T 46N R 1E B-7
- T _____ R _____
- T _____ R _____
- T _____ R _____
- 2. Property Controlling S _____ T _____ R _____
- in Section S _____ T _____ R _____
- 3. Miscellaneous S _____ T _____ R _____
- Property in Sec. S _____ T _____ R _____

RECEIVED FOR RECORD
CHIPPEWA COUNTY
STATE OF MICHIGAN

93 NOV 31 AM 10:47

J. Roger Matlock
REGISTER OF DEEDS

Register of Deeds Stamp & File Number

- 4. Lot No. _____, Recorded Plat _____
- 5. Private Claims _____

A	B	C	D	E	F	G	H	I	J	K	L	M
2	6	5	4	3	2	1						
3												
4	7	8	9	10	11	12						
5												
6	18	17	16	15	14	13						
7	●											
8	19	20	21	22	23	24						
9												
10	30	29	28	27	26	25						
11												
12	31	32	33	34	35	36						
13												

I, Larry R. Rogers, in a field survey on November 9, 1993, do hereby certify that under requirements of P.A. 74, Michigan P.A. of 1970, the corner points mentioned in lines 1 and 2 above were in conformance with regulations and rules therefore as required in the current manual of survey instructions of the United States Department of the Interior, Bureau of Land Management or by a decree of a Court of Law and/or that the corner points mentioned in lines 3, 4 and 5 above were in conformance with the rules of the Michigan Board of Land Surveyors or by a Decree of a Court of Law; established, re-established, monumented, re-monumented, recovered, found as expressed below:

NOTE: Not more than 4 corners, all in the same town and range, may be recorded on this certificate.

A. Description of original monument and accessories and/or subsequent restoration:

(B-7) 1/4 Corner Common to Sections 18 & 19, T46N-R1E

This corner was previously recorded in 1985 by Larry R. Rogers, P.S. 29251 in Liber 6, Page 282 of the Chippewa County Corner Records as a 3/4" iron bar in centerline of 9 Mile Road with the following witnesses.

- 12" Spruce N20°E 136.87'
- Power Pole (#77) S14°E 54.65'
- 10" Maple in Clump N34°E 82.36'
- PK in Centerline M-129 Due West 98.95'
- Concrete right-of-way marker S40°E 60.55'

B. Description of corner evidence found and/or method applied in restoring or reestablishing corner:



(B-7) This corner is being perpetuated as part of the Chippewa County Remonumentation Program.

The 3/4" iron bar was removed by the Chippewa County Road Commission during reconstruction of 9 Mile Road and an empty monument box was replaced at the approximate corner position. Four of the witnesses from the 1985 records were recovered and indicate that the corner position is 1.65 feet Northeast of the center of the monument box. Set a 3/4" x 24" iron pin with plastic cap at position indicated by the recovered witnesses and used monument box as a new witness.

C. Description of monument for corner and accessories established to perpetuate locating the position of the corner:

(B-7) Corner is a 3/4" x 24" iron pin with plastic remonumentation cap in centerline of 9 Mile Road.

- Witnesses: 12" Spruce N20°E 136.87'
- 10" Maple in Clump N34°E 82.35'
- Concrete right-of-way marker S40°E 60.43'
- Utility Pole (#77) S14°E 54.60'
- Utility Pole N67°W 153.02'
- Monument Box S54°W 1.65'

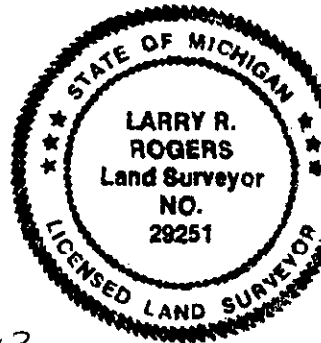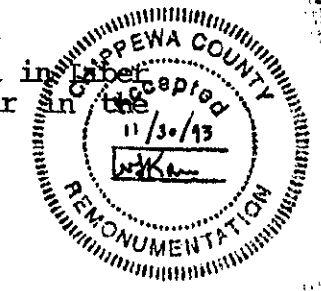

Signed by [Signature] Date 11 Nov 1993

Surveyor's Michigan License No. 29251

NOTE: Bearings are compass bearings corrected for declination. Distances are to a nail in side of witness objects unless noted.