

SURVEY & REMONUMENTATION

LAND CORNER RECORDATION CERTIFICATE
Filing Requirement of Act 74, Mich. P.A. 1970
Chippewa County Remonumentation Corner

MAY 28 1997

For corners in

Chippewa County COMMISSION

Located in: Corner Code #
1. Public Land Survey T46N R1E B-9
T R
T R
T R
2. Property Controlling S T R
in Section S T R
3. Miscellaneous S T R
Property in Sec. S T R
4. Lot No. , Recorded Plat
5. Private Claims

\$7.00 LAND CORNER

\$2.00 MSSR


2/28/1997 3:16:11 PM Receipt #217
RECEIVED FOR RECORD
CHIPPewa COUNTY - STATE OF MICHIGAN
SHARON H. KENNEDY, REGISTER OF DEED

BOOK 9 PAGE 381

Register of Deeds Stamp & File Number

I, William L. Karr, in a field survey on September 15, 1996, do hereby state that under requirements of P.A. 74, Michigan P.A. of 1970, the corner points mentioned in lines 1 and 2 above were in conformance with regulations and rules therefore as required in the current manual of survey instructions of the United States Department of the Interior, Bureau of Land Management or by a decree of a Court of Law and /or that the corner points mentioned in lines 3, 4 and 5 above were in conformance with the rules of the Michigan Board of Land Surveyors or by a Decree of a Court of Law; established, re-established, monumented, recovered, found as expressed below:

NOTE: Not more than 2 corners, all in the same town and range, may be recorded on this certificate.

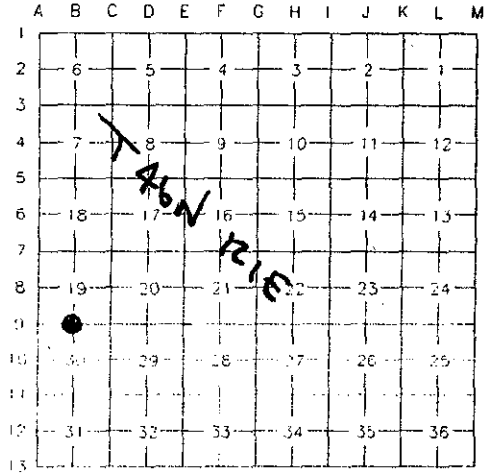

A. Description of original monument and accessories and/or subsequent restoration:

(B-9) 1/4 Corner Common to Sections 19 & 30, T. 46 N., R. 1 E.

1845 J.H. Mullett set post 39.20 ch East of Range Line

1985 L.R. Rogers PS 29251 set a 1/2" x 24" iron with cap for 1/4 corner. Position for corner established from local evidence. Corner recorded Liber 6, Page 283, Chippewa County Corner Records.

B. Description of corner evidence found and/or method applied in restoring or reestablishing corner:

(B-9) 1/4 Corner Common to Sections 19 & 30, T. 46 N., R. 1 E.

This corner is being perpetuated as part of the Chippewa County Remonumentation Program.

Found corner as recorded by L.R. Rogers in 1985. Other than local evidence, e.g. fences and roads, no other evidence of corner perpetuation could be found.

At the present location the corner falls 8.4' West of a proportionate GLO distance.

Accepted the corner position as found.



C. Description of monument for corner and accessories established to perpetuate locating the position of the corner:

(B-9) 1/4 Corner Common to Sections 19 & 30, T. 46 N., R. 1 E.

Corner is a 1/2" x 24" re-bar with plastic cap no. 29251, 8' North of centerline 10 Mile Road (gravel). Corner is 0.2' below grade.

Witnesses: 18" Spruce N 84° E 93.95'
9" Spruce S 09° E 90.84'
8" Spruce S 34° W 68.08'
16" Spruce N 32° W 38.91'



Bearings are compass bearings corrected for declination, all distances are to a nail and tag in the side of the witness except unless otherwise noted.

Signed by William L. Karr

Date 12-30-96

Surveyor's Michigan License No. 27450