

MAY 28 1997

COMMISSION

LAND CORNER RECORDATION CERTIFICATE

Filing Requirement of Act 74, Mich. P.A. 1970

Chippewa County Remonumentation Corner \$7.00 LAND CORNER


For corners in

| Chippewa County | Located in: | Corner Code # |
|------------------------------------|-------------|---------------|
| 1. Public Land Survey | T46N R1E | B-11 |
| | T R | |
| | T R | |
| | T R | |
| 2. Property Controlling in Section | S T R | |
| | S T R | |
| 3. Miscellaneous Property in Sec. | S T R | |
| | S T R | |
| 4. Lot No. , Recorded Plat | | |
| 5. Private Claims | | |

\$2.00 MSSR
2/28/1997 3:17:21 PM Receipt #217
RECEIVED FOR RECORD
CHIPPEWA COUNTY - STATE OF MICHIGAN
SHARON H. KENNEDY, REGISTER OF DEED

BOOK 9 PAGE 380

Register of Deeds Stamp & File Number

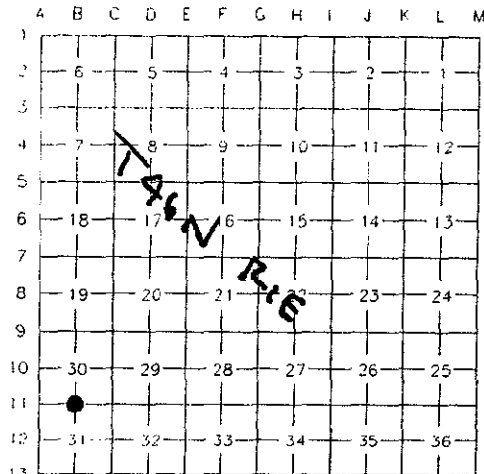

I, William L. Karr, in a field survey on October 15, 1996, do hereby state that under requirements of P.A. 74, Michigan P.A. of 1970, the corner points mentioned in lines 1 and 2 above were in conformance with regulations and rules therefore as required in the current manual of survey instructions of the United States Department of the Interior, Bureau of Land Management or by a decree of a Court of Law and /or that the corner points mentioned in lines 3, 4 and 5 above were in conformance with the rules of the Michigan Board of Land Surveyors or by a Decree of a Court of Law; established, re-established, monumented, recovered, found as expressed below:

NOTE: Not more than 2 corners, all in the same town and range, may be recorded on this certificate.

A. Description of original monument and accessories and/or subsequent restoration:

(B-11) 1/4 Corner Common to Sections 30 & 31, T. 46 N., R. 1 E.

1845 J.H. Mullett set post in Original Survey.

Witnesses: 10" Fir S 63 W 19 lks
8" Maple N 24 W 29 lks

Could find no other history on this corner position.

B. Description of corner evidence found and/or method applied in restoring or reestablishing corner:

(B-11) 1/4 Corner Common to Sections 30 & 31, T. 46 N., R. 1 E.

This corner is being perpetuated as part of the Chippewa County Remonumentation Program.

Found no evidence of original survey corner. GLO distance on the mile between sections 30 and 31 is 5190.24' (78.64 ch), the measured distance is 5338.71. There is a stream call on the random line going West at 3597', the measured distance is approximately 3750'. This is typical of the inconsistencies in the GLO vs. actual measurements in the South half of this township.

Found a 1/2" iron in the centerline of an East-West gravel road. The iron is 0.3' West and 1.3' North of being on line and at a pro-rated GLO distance between the section corners to the East and West. Accepted the 1/2" iron for the corner position.

C. Description of monument for corner and accessories established to perpetuate locating the position of the corner:

(B-11) 1/4 Corner Common to Sections 30 & 31, T. 46 N., R. 1 E.

Corner is a 1/2" iron in the centerline of an East-West gravel road on the range of the Westerly of two fencelines running North.

Witnesses:

| | | |
|-------------------|---------|----------|
| End Fence Post | N 07° E | 44.37' |
| Corner Fence Post | N 62° E | 37.52' |
| Section Corner | East | 2715.90' |
| Section Corner | West | 2622.81' |
| Power Pole | N 65° W | 77.35' |

Bearings are compass bearings, corrected for declination, all distances are to a nail and tag in the side of the witness object unless otherwise noted.

Signed by William L. Karr

Date 12-30-96

Surveyor's Michigan License No. 27450

FORM APPROVED BY MICHIGAN STATE BOARD OF PROFESSIONAL SURVEYORS, JAN. 28, 1971
REVISED MAY 14, 1975
REVISED JAN., 1983
REVISED OCT., 1995

BOOK 9 PAGE 380

