

**SURVEY &
REMONUMENTATION**

Chippewa County Remonumentation Corner

RECEIVED FOR RECORD
CHIPPEWA COUNTY
STATE OF MICHIGAN

MAR 09 1994

LAND CORNER RECORDATION CERTIFICATE
Filing Requirement of Act 74, Mich. P.A. 1970

93 DEC 14 PM 4: 25

For corners **COMMISSION**
Chippewa
(County)


Located In: Corner Code ##

J. Roger Malott
REGISTER OF DEEDS

- | | | | | | |
|---------------------------------------|---|------------|---|-----------|------------|
| 1. Public Land Survey | T | <u>46N</u> | R | <u>1E</u> | <u>C-3</u> |
| | T | _____ | R | _____ | _____ |
| | T | _____ | R | _____ | _____ |
| | T | _____ | R | _____ | _____ |
| 2. Property Controlling In Section | S | _____ | T | _____ | _____ |
| | S | _____ | T | _____ | _____ |
| 3. Miscellaneous Property in Sec. | S | _____ | T | _____ | _____ |
| | S | _____ | T | _____ | _____ |
4. Lot No. _____, Recorded Plat _____
5. Private Claims _____

Register of Deeds Stamp & File Number

I, William L. Karr, in a field survey on November 22, 19 93, do hereby certify that under requirements of P.A. 74, Michigan P.A. of 1970, the corner points mentioned in lines 1 and 2 above were in conformance with regulations and rules therefore as required in the current manual of survey instructions of the United States Department of the Interior, Bureau of Land Management or by a decree of a Court of Law and/or that the corner points mentioned in lines 3, 4 and 5 above were in conformance with the rules of the Michigan Board of Land Surveyors or by a Decree of a Court of Law; established, re-established, monumented, re-monumented, recovered, found as expressed below:

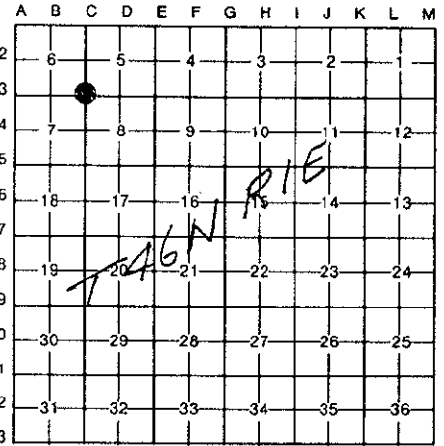

NOTE: Not more than 4 corners, all in the same town and range, may be recorded on this certificate.


A. Description of original monument and accessories and/or subsequent restoration:
(C-3) Section Corner Common to Sections 5, 6, 7, & 8, (T46N-R1E)

This corner was recorded by William L. Karr, L.S. 27450 in Liber 7, Page 315 of the Chippewa County Corner Records as a 3/4" square iron with the following witnesses:

- | | | |
|------------------------|-------|---------|
| Phone Cable Splice Box | S10°E | 32.27' |
| Power Pole | N74°W | 141.15' |
| "V" Notch in C.M.P. | N58°W | 40.82' |

B. Description of corner evidence found and/or method applied in restoring or reestablishing corner:
(C-3) This corner is being perpetuated as part of the Chippewa County Remonumentation Program.

Found 3/4" square iron and witnesses as called for. Accepted corner position as found and added three new witnesses.

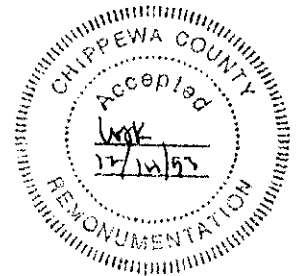

C. Description of monument for corner and accessories established to perpetuate locating the position of the corner:
(C-3) Corner is a 3/4" square iron. Falls approximately 3' North of the centerline of Seven Mile Road (gravel) and 20' East of the centerline of Killackey Road to the North.

- | | | |
|-----------------------------------|-------|---------|
| Witnesses: Phone Cable Splice Box | S10°E | 32.27' |
| Power Pole | N74°W | 140.99' |
| "V" Notch in C.M.P. | N58°W | 40.82' |
| Power Pole (DR1/107/14) | N19°E | 28.51' |
| Anchor Pole | S06°E | 35.96' |
| 1" Iron Pipe with pinched top | S42°W | 45.10' |



Signed by William L. Karr Date 12/14/93

Surveyor's Michigan License No. 27450

NOTE: Bearings are compass bearings corrected for declination.
Distances are to a nail in side of witness objects unless noted.