

LAND CORNER RECORDATION CERTIFICATE
Filing Requirement of Act 74, Mich. P.A. 1970

For corners in
Chippewa
 (County)

Located In:	Corner Code #
T <u>46N</u> R <u>1E</u>	<u>C-4</u>
T _____ R _____	_____
T _____ R _____	_____
T _____ R _____	_____
T _____ R _____	_____
2. Property Controlling in Section S _____ T _____ R _____	_____
S _____ T _____ R _____	_____
3. Miscellaneous S _____ T _____ R _____	_____
Property in Sec. S _____ T _____ R _____	_____


RECEIVED FOR RECORD
 CHIPPEWA COUNTY
 STATE OF MICHIGAN

94 JUL 22 AM 11:17

J. Roger Melick

REGISTER OF DEEDS
 Register of Deeds Stamp & File Number

4. Lot No. _____, Recorded Plat _____
 5. Private Claims _____

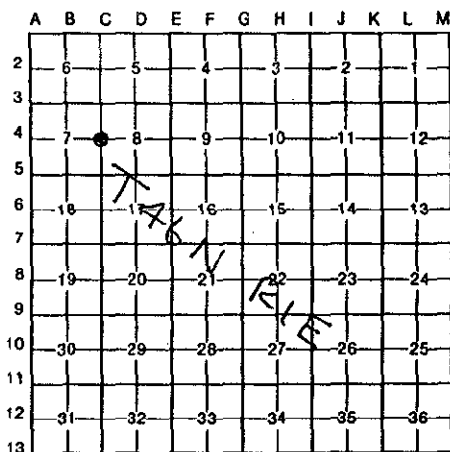

I, William L. Karr, in a field survey on DECEMBER 1, 19 93, do hereby certify that under requirements of P.A. 74, Michigan P.A. of 1970, the corner points mentioned in lines 1 and 2 above were in conformance with regulations and rules therefore as required in the current manual of survey instructions of the United States Department of the Interior, Bureau of Land Management or by a decree of a Court of Law and/or that the corner points mentioned in lines 3, 4 and 5 above were in conformance with the rules of the Michigan Board of Land Surveyors or by a Decree of a Court of Law; established, re-established, monumented, re-monumented, recovered, found as expressed below:

NOTE: Not more than 4 corners, all in the same town and range, may be recorded on this certificate.

A. Description of original monument and accessories and/or subsequent restoration:
(C-4) West 1/4 Corner of Section 8 (T46N-R1E)

Original ties:

Birch 18	N68°E	16 links	Fir 12	S84°W	20 links
<u>1990: Keith R. Waters re-established corner (Liber 7, Page 249).</u>					
4" Spruce			N85°W		211.92'
6" Spruce			S05°E		109.74'
5" Spruce			S42°E		117.06'
4" Poplar			S53°E		157.83'
Fence Corner (West and South)			East		24.75'

B. Description of corner evidence found and/or method applied in restoring or reestablishing corner:

(C-4) Found corner and all accessories as recorded in Liber 7, Page 249 of the Chippewa County Records. Accepted corner position as found.

**SURVEY &
 REMONUMENTATION**

JUL 26 1994

COMMISSION

C. Description of monument for corner and accessories established to perpetuate locating the position of the corner:
(C-4) Corner is a 1/2" x 18" rerod with cap #33142.

Ties:	4" Spruce	N85°W	211.92'
	6" Spruce	S05°E	109.74'
	5" Spruce	S42°E	117.06'
	4" Poplar	S53°E	157.83'
	Fence Corner (West and South)	East	24.75'



Signed by William L. Karr Date 7/21/94
 Surveyor's Michigan License No. 27450

**NOTE: Bearings are compass bearings corrected for declination.
 Distances are to a nail in side of witness objects unless noted.**