

MAR 09 1994

Chippewa County Remonumentation Corner

RECEIVED FOR RECORD
CHIPPEWA COUNTY
STATE OF MICHIGAN

LAND CORNER RECORDATION CERTIFICATE
Filing Requirement of Act 74, Mich. P.A. 1970

93 DEC 14 PM 4: 26

COMMISSION

For corners in

Chippewa
(County)

Located In:

Corner Code #

- 1. Public Land Survey T 46N R 1E C-6
- T _____ R _____
- T _____ R _____
- T _____ R _____
- T _____ R _____
- 2. Property Controlling S _____ T _____ R _____
- in Section S _____ T _____ R _____
- 3. Miscellaneous S _____ T _____ R _____
- Property in Sec. S _____ T _____ R _____

J. Roger Mullett
REGISTER OF DEEDS

Register of Deeds Stamp & File Number

- 4. Lot No. _____, Recorded Plat _____
- 5. Private Claims _____

I, William L. Karr, in a field survey on November 29, 19 93, do hereby certify that under requirements of P.A. 74, Michigan P.A. of 1970, the corner points mentioned in lines 1 and 2 above were in conformance with regulations and rules therefore as required in the current manual of survey instructions of the United States Department of the Interior, Bureau of Land Management or by a decree of a Court of Law and/or that the corner points mentioned in lines 3, 4 and 5 above were in conformance with the rules of the Michigan Board of Land Surveyors or by a Decree of a Court of Law; established, re-established, monumented, re-monumented, recovered, found as expressed below:

NOTE: Not more than 4 corners, all in the same town and range, may be recorded on this certificate.

A. Description of original monument and accessories and/or subsequent restoration:
(C-6) 1/4 Corner Common to Sections 17 & 18, (T46N-R1E)

1845: James H. Mullett, D.S.
Set Post.
Birch 10 S10°E 11 links
Fir 12 N27°W 13 links

B. Description of corner evidence found and/or method applied in restoring or reestablishing corner:



(C-6) This corner is being re-established as part of the Chippewa County Remonumentation Program.

Found no evidence of original corner. County Surveyor notes for Section 17 and Section 18 indicate an overall distance of 5349' for this mile, today's measurement is 5361.05'. County Surveyor notes for Section 18 indicate 2674' for the South 1/2 mile. We measured 2675.11 from the Southeast corner of 18 to an existing fence on the East-West 1/4 line of Section 17. Re-established 1/4 corner on line between the Section corners and on the East-West 1/4 line fence.

C. Description of monument for corner and accessories established to perpetuate locating the position of the corner:

(C-6) Corner is a 3/4" iron with stamped, aluminum cap (Chippewa County Remonumentation) at base of fence post. Fence line to North and East.

Witnesses: Corner Fence Post N70°E 0.81'
4" Spruce East 10.92'
4" Spruce S45°E 35.46'
5" Spruce S59°W 12.24'
4" Spruce West 11.21'

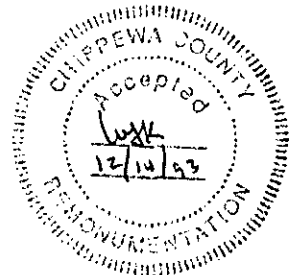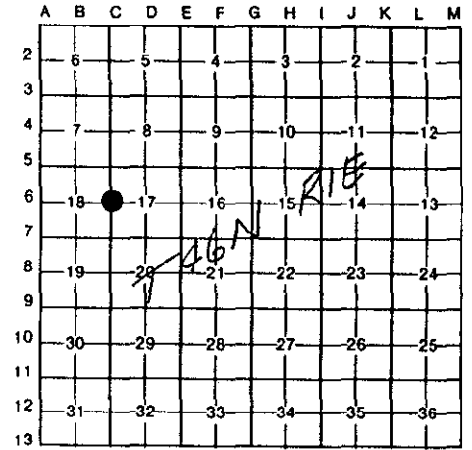

Signed by William L. Karr Date 12/14/93

Surveyor's Michigan License No. 27450

NOTE: Bearings are compass bearings corrected for declination.
Distances are to a nail in side of witness objects unless noted.