

MAY 28 1997

COMMISSION


LAND CORNER RECORDATION CERTIFICATE
Filing Requirement of Act 74, Mich. P.A. 1970
Chippewa County Remonumentation Corner

\$7.00 LAND CORNER

For corners in

Chippewa County	Located in:	Corner Code #
1. Public Land Survey	T46N R1E	C-8
	T R	
	T R	
	T R	
2. Property Controlling in Section	S T R R	
	S T R R	
3. Miscellaneous Property in Sec.	S T R R	
	S T R	
4. Lot No. , Recorded Plat		
5. Private Claims		

\$2.00 MSSR
 2/28/1997 3:16:07 PM Receipt #217
 RECEIVED FOR RECORD
 CHIPPEWA COUNTY - STATE OF MICHIGAN
 SHARON H. KENNEDY, REGISTER OF DEED
 BOOK 9 PAGE 379
 Register of Deeds Stamp & File Number

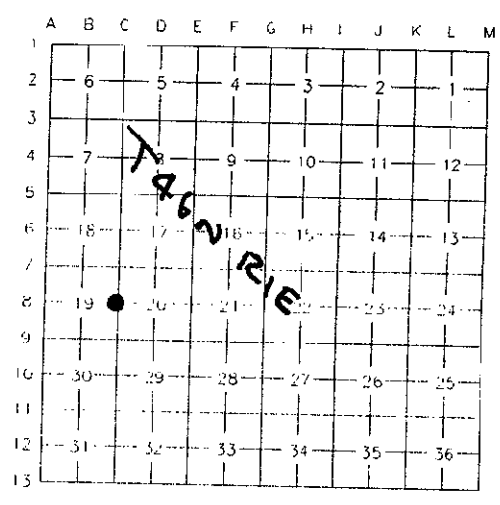

I, William L. Karr, in a field survey on November 15, 1996, do hereby state that under requirements of P.A. 74, Michigan P.A. of 1970, the corner points mentioned in lines 1 and 2 above were in conformance with regulations and rules therefore as required in the current manual of survey instructions of the United States Department of the Interior, Bureau of Land Management or by a decree of a Court of Law and /or that the corner points mentioned in lines 3, 4 and 5 above were in conformance with the rules of the Michigan Board of Land Surveyors or by a Decree of a Court of Law; established, re-established, monumented, recovered, found as expressed below:

NOTE: Not more than 2 corners, all in the same town and range, may be recorded on this certificate.

A. Description of original monument and accessories and/or subsequent restoration:

(C-8) 1/4 Corner Common to Sections 19 & 20, T. 46 N., R. 1E.

1845 Original Survey, JH Mullett, 6" Birch for 1/4 section corner.

1983 Survey by LR Rogers PS 29251 in section 19 used fence corner for position of corner; fences North South and West.

B. Description of corner evidence found and/or method applied in restoring or reestablishing corner:

(C-8) 1/4 Corner Common to Sections 19 & 20, T. 46 N., R. 1E.

This corner is being reestablished as part of the Chippewa County Remonumentation Program

Other than the 1983 survey by LR Rogers there is no survey information on this corner position. Original notes do not mention the Charlotte River that crosses the section line South of the 1/4 corner. Found an older fence line to the West approximately 5' North of fence line in 1983 survey.

Corner re-established on old North-South fence line mid-way between the section corners to the North and South. This position closely matches the old fence line running West and is 5' north of the position used by Rogers in his 1983 survey.

C. Description of monument for corner and accessories established to perpetuate locating the position of the corner:

(C-8) 1/4 Corner Common to Sections 19 & 20, T. 46 N., R. 1E.

Corner is a 3/4" x 24" re-bar with stamped Chippewa County Remonumentation cap. The corner falls 20' West of the West bank of the Charlotte River at the Northeast corner of a field.

Witnesses:	Metal Fence Post	North	2.00'
	Corner Fence Post	S 10° E	9.30'
	16" White Spruce	N 51° W	52.70'
	14" White Spruce	N 06° W	76.80'

Bearings are compass bearings, corrected for declination, all distances are to a nail and tag in the side of the witness object, unless otherwise noted.

Signed by William L. Karr

Date 12-30-96

Surveyor's Michigan License No. 27450

