

MAY 28 1997

**LAND CORNER RECORDATION CERTIFICATE**  
**Filing Requirement of Act 74, Mich. P.A. 1970**

Chippewa County Remonumentation Corner \$7.00 LAND CORNER


For corners in **COMMISSION**

Chippewa County	Located in:	Corner Code #
1. Public Land Survey	T46N R1E	C-9
	T R	
	T R	
	T R	
2. Property Controlling in Section	S T R	
	S T R	
3. Miscellaneous Property in Sec.	S T R	
	S T R	
4. Lot No. , Recorded Plat		
5. Private Claims		

\$2.00 MBSR  
 2/28/1997 3:15:25 PM Receipt #217  
 RECEIVED FOR RECORD  
 CHIPPEWA COUNTY - STATE OF MICHIGAN  
 SHARON H. KENNEDY, REGISTER OF DEEDS

BOOK 9 PAGE 378

Register of Deeds Stamp & File Number

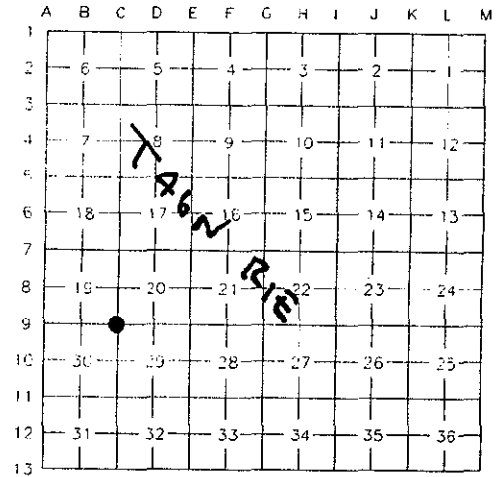

I, William L. Karr, in a field survey on December 4, 1996, do hereby state that under requirements of P.A. 74, Michigan P.A. of 1970, the corner points mentioned in lines 1 and 2 above were in conformance with regulations and rules therefore as required in the current manual of survey instructions of the United States Department of the Interior, Bureau of Land Management or by a decree of a Court of Law and/or that the corner points mentioned in lines 3, 4 and 5 above were in conformance with the rules of the Michigan Board of Land Surveyors or by a Decree of a Court of Law, established, re-established, monumented, recovered, found as expressed below:

NOTE: Not more than 2 corners, all in the same town and range, may be recorded on this certificate.

**A. Description of original monument and accessories and/or subsequent restoration:**

(C-9) Section Corner Common to Sections 19, 20, 30, & 29, T. 46 N., R. 1 E.

- 1845 J.H. Mullett set post in Original Survey.
- 1904 F.H. Brown in records in County Surveyors Office for a survey in section 29 shows a discrepancy of 332' North-South for the Corner position. Brown made his survey based on the Northerly position.
- 1965 J.P. Smallwood found a 3/4" iron bolt for the corner and shows a distance to the section corner to the South as being 4910.73', this distance matches the Southerly corner noted by Brown in 1904. Corner Recorded Liber 2, Page 246, Chippewa County Records.
- 1983 W.L. Karr, Northwoods Land Surveying, Job 141-129, found the 3/4" bolt recorded by Smallwood in 1965 in road intersection, 1.5' below road surface.

**B. Description of corner evidence found and/or method applied in restoring or reestablishing corner:**

(C-9) Section Corner Common to Sections 19, 20, 30, & 29, T. 46 N., R. 1 E.

This corner is being perpetuated as part of the Chippewa County Remonumentation Program.

Found the corner as recorded by Smallwood in 1965. This position appears to have been established at a split of the three miles North from the South Township Boundary. Brown's notes from 1904 mention this corner but Brown used a position 332' North for his survey in Section 29, he does not elaborate on his reasoning or evidence.

The present position for the corner appears to be a perpetuation of the Southerly position and works well with development in the area. There is no remaining evidence of the Northerly corner used by Brown. Accepted corner position as found.

**C. Description of monument for corner and accessories established to perpetuate locating the position of the corner:**

(C-9) Section Corner Common to Sections 19, 20, 30, & 29, T. 46 N., R. 1 E.

Corner is a 3/4" square head bolt South of the centerline of 10 mile road and just East of the centerline of a two track road to the South. Corner is approximately 1' below grade.

Witnesses:	Corner Fence Post	S 22° E	31.68'
	Fence Post	S 03° E	89.14'
	7" Aspen	N 69° W	125.28'
	Utility Pole (DR1/76H/17)	N 42° W	58.27'

Bearings are compass bearings, corrected for declination, all distances are to a nail and tag in the side of the witness post, unless otherwise noted.

Signed by William L. Karr

Date 12-30-96

Surveyor's Michigan License No. 27450

