

MAY 28 1997

LAND CORNER RECORDATION CERTIFICATE

Filing Requirement of Act 74, Mich. P.A. 1970

Chippewa County Remonumentation Corner \$7.00 LAND CORNER

For corners in COMMISSION

Chippewa County	Located in:	Corner Code #
1. Public Land Survey	T46 N R1 E	C-10
	T R	
	T R	
	T R	
2. Property Controlling in Section	S T R	
	S T R	
3. Miscellaneous Property in Sec.	S T R	
	S T R	
4. Lot No. , Recorded Plat		
5. Private Claims		


\$2.00 MSSR
2/26/1997 3:14:34 PM Receipt #217
RECEIVED FOR RECORD
CHIPPEWA COUNTY - STATE OF MICHIGAN
SHARON H. KENNEDY, REGISTER OF DEEDS

BOOK 9 PAGE 377

Register of Deeds Stamp & File Number

I, William L. Karr, in a field survey on October 1, 1996, do hereby state that under requirements of P.A. 74, Michigan P.A. of 1970, the corner points mentioned in lines 1 and 2 above were in conformance with regulations and rules therefore as required in the current manual of survey instructions of the United States Department of the Interior, Bureau of Land Management or by a decree of a Court of Law and /or that the corner points mentioned in lines 3, 4 and 5 above were in conformance with the rules of the Michigan Board of Land Surveyors or by a Decree of a Court of Law; established, re-established, monumented, recovered, found as expressed below:

NOTE: Not more than 2 corners, all in the same town and range, may be recorded on this certificate.

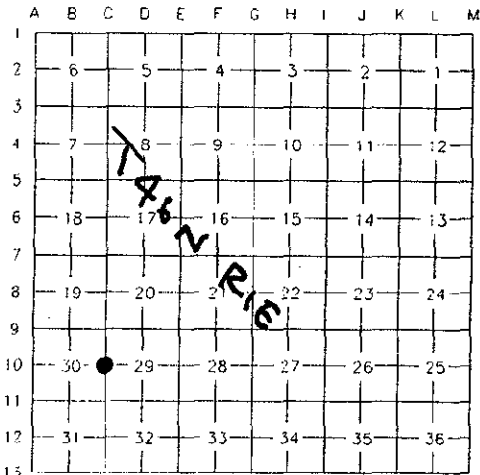

A. Description of original monument and accessories and/or subsequent restoration:

(C-10) 1/4 Corner Common to Sections 30 & 29, T. 46 N., R. 1 E.

1845 J.H. Mullett in Original Survey, 10" Fir for 1/4 section post.

1904 F.H. Brown in records in Chippewa County Surveyors Office in a survey of Section 29 shows no evidence of original corner. Brown shows the mile on the West side of section 29 as 5232' and divided up evenly.

B. Description of corner evidence found and/or method applied in restoring or reestablishing corner:

(C-10) 1/4 Corner Common to Sections 30 & 29, T. 46 N., R. 1 E.

This corner is being reestablished as part of the Chippewa County Remonumentation Program.

Could find no history on corner subsequent to Brown's 1904 survey. Area around the 1/4 corner is now pasture land with well established 1/4 line fences running East and West. The distance to the section corner to the South works well with Brown's 1904 survey, the distance to the section corner to the North is 324' short of that shown in Brown's survey. Brown noted in his survey that there was some dispute as to the location of the Northwest corner of section 29 and he placed his corner 332' North of the position previously accepted as the corner.

Accepted the 1/4 line fences and an old North-South road as the best remaining evidence of Brown's survey and accepted Brown's position for 1/4 corner.

C. Description of monument for corner and accessories established to perpetuate locating the position of the corner:

(C-10) 1/4 Corner Common to Sections 30 & 29, T. 46 N., R. 1 E.

Corner is a 3/4" x 24" re-bar with plastic Chippewa County Remonumentation cap set in centerline of an old North-South road and on the range of 1/4 line fences to the East and West. Corner is set 1' below grade.

Witnesses:	Fence Post	N 21° E	51.25'
	(first post North of fence corner)		
	Fence Post	S 83° W	17.45'
	(end post of fence to West)		
	10" White Pine	N 56° W	153.22'
	16" White Spruce	N 12° W	149.95'

Bearings are compass bearings, corrected for declination, all distances are to a nail and tag in the side of the witness object unless otherwise noted.

Signed by William L. Karr

Date 12-30-96

Surveyor's Michigan License No. 27450

