

SURVEY & REMONUMENTATION

1993

Chippewa County Remonumentation Corner

LAND CORNER RECORDATION CERTIFICATE

Filing Requirement of Act 74, Mich. P.A. 1970

For corners in

COMMISSION

Chippewa

(County)

Located In:

Corner Code #

- | | | |
|---------------------------------------|--------------------------|-------|
| 1. Public Land Survey | T <u>46N</u> R <u>1E</u> | D-7 |
| | T _____ R _____ | _____ |
| | T _____ R _____ | _____ |
| | T _____ R _____ | _____ |
| 2. Property Controlling in Section | S _____ T _____ R _____ | _____ |
| | S _____ T _____ R _____ | _____ |
| 3. Miscellaneous Property in Sec. | S _____ T _____ R _____ | _____ |
| | S _____ T _____ R _____ | _____ |
| 4. Lot No. _____, Recorded Plat _____ | | |
| 5. Private Claims _____ | | |

RECEIVED FOR RECORD
CHIPPEWA COUNTY
STATE OF MICHIGAN

93 NOV 31 AM 10:48

J. Roger Mallett

REGISTER OF DEEDS

Register of Deeds Stamp & File Number

I, Larry R. Rogers, in a field survey on November 10, 1993

do hereby certify that under requirements of P.A. 74, Michigan P.A. of 1970, the corner points mentioned in lines 1 and 2 above were in conformance with regulations and rules therefore as required in the current manual of survey instructions of the United States Department of the Interior, Bureau of Land Management or by a decree of a Court of Law and/or that the corner points mentioned in lines 3, 4 and 5 above were in conformance with the rules of the Michigan Board of Land Surveyors or by a Decree of a Court of Law; established, re-established, monumented, re-monumented, recovered, found as expressed below:

NOTE: Not more than 4 corners, all in the same town and range, may be recorded on this certificate.

A. Description of original monument and accessories and/or subsequent restoration:

(D-7) 1/4 Corner Common to Sections 17 and 20, T46N-R1E

Original Survey Notes: 18 Sept. 1845, James H. Mullett set quarter section post
Witnesses: 15" Birch S 17 E 29 links
12" Cedar N 82 W 23 links

County Surveyor notes dated August 1905 recite distance from South 1/4 corner of Section 17 to Southwest corner as 2644.0 feet and to Southeast corner as 2642.0 feet.

B. Description of corner evidence found and/or method applied in restoring or reestablishing corner:



(D-7) This corner is being perpetuated as part of the Chippewa County Remonumentation Program.

Found no evidence of original corner position or subsequent restoration. Placed 3/4" x 24" iron pin on line between the Southwest and Southeast corners of Section 17 and on the extension of an old fence line to the North. Distances East and West check very well with old County Surveyor notes.

C. Description of monument for corner and accessories established to perpetuate locating the position of the corner:

(D-7) Corner is a 3/4" x 24" iron pin with plastic remonumentation cap, 4.6 feet North of the centerline of 9 Mile Road.

Witnesses: 9" Double Spruce (blazed) N23°W 46.50'
6" Spruce (blazed) N09°E 44.44'
Utility Pole S70°E 206.81'
Utility Pole S66°W 124.41'

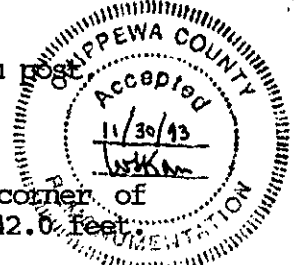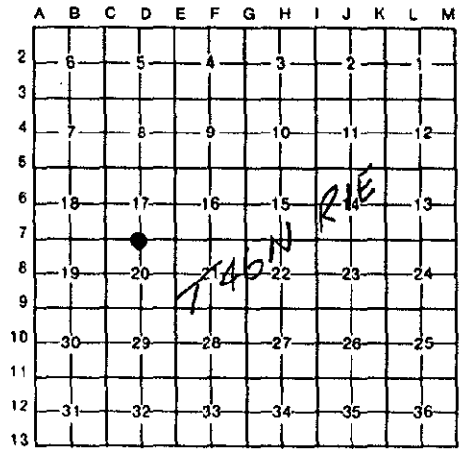

Signed by *[Signature]*

Date 11 Nov 1993

Surveyor's Michigan License No. 29251

NOTE: Bearings are compass bearings corrected for declination. Distances are to a nail in side of witness objects unless noted.