

APR 07 1998

LAND CORNER RECORDATION CERTIFICATE

Filing Requirement of Act 74, Mich. P.A. 1970

Chippewa County Remonumentation Corner **\$7.00 LAND CORNER**

SECTION


For corners in

Chippewa County	Located in:	Corner Code #
1. Public Land Survey	T46N R1E	D-11
	T R	
	T R	
	T R	
2. Property Controlling in Section	S T R	
	S T R	
3. Miscellaneous Property in Sec.	S T R	
	S T R	
4. Lot No. , Recorded Plat		
5. Private Claims		

\$2.00 MSSR
18 Feb 1998 1:39:06 PM Receipt #6148
RECEIVED FOR RECORD
CHIPPWEA COUNTY - STATE OF MICHIGAN
SHARON H. KENNEDY, REGISTER OF DEEDS

BOOK 10 PAGE 152

Register of Deeds Stamp & File Number

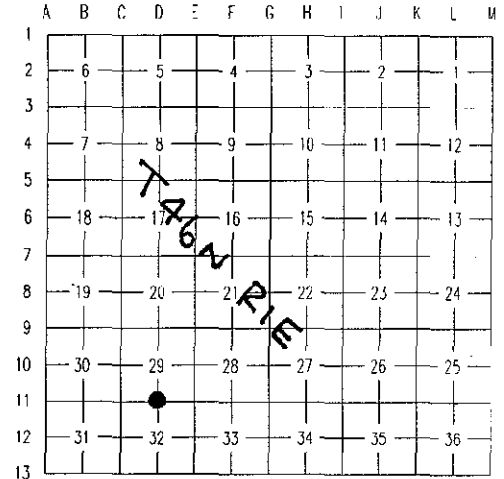

I, William L. Karr, in a field survey on October 27, 1997, do hereby state that under requirements of P.A. 74, Michigan P.A. of 1970, the corner points mentioned in lines 1 and 2 above were in conformance with regulations and rules therefore as required in the current manual of survey instructions of the United States Department of the Interior, Bureau of Land Management or by a decree of a Court of Law and for that the corner points mentioned in lines 3, 4 and 5 above were in conformance with the rules of the Michigan Board of Land Surveyors or by a Decree of a Court of Law; established, re-established, monumented, recovered, found as expressed below:

NOTE: Not more than 2 corners, all in the same town and range, may be recorded on this certificate.

A. Description of original monument and accessories and/or subsequent restoration:

(D-11) 1/4 Corner Common to Sections 29 and 32, T. 46 N., R. 1 E.

1845 J.H. Mullett set post for corner in original survey.

Witnesses: 10" Tamarack N 45° W 21 lks
12" Tamarack S 75° E 18 lks

1898 F.H. Brown in field book and section drawing book in County Surveyors Office shows a survey of section 32. Brown notes that he could find no trace of the original corner. The notes show the mile as 5210' and evenly divided.

1904 F.H. Brown in the section drawing book in County Surveyors Office shows a survey of section 29. Again Brown states that no trace of the original corner was found and that the mile measured 5208' and was evenly divided.

B. Description of corner evidence found and/or method applied in restoring or reestablishing corner:

(D-11) 1/4 Corner Common to Sections 29 and 32, T. 46 N., R. 1 E.

This corner is being perpetuated as part of the Chippewa County Remonumentation Program.

Found no evidence of the original corner or of subsequent restoration. Reestablished corner equal distance between the section corners to the East and West and 30' South of an East-West fence. This position falls in the centerline of an East-West road and on the range of 1/4 line fences to the North and South. The position for the 1/4 corner falls 7.83' North of a line between the section corners and the distances East and West measure 2609.46'.

C. Description of monument for corner and accessories established to perpetuate locating the position of the corner:

(D-11) 1/4 Corner Common to Sections 29 and 32, T. 46 N., R. 1 E.

Corner is a 1/2" x 24" re-bar with plastic Chippewa County Remonumentation Corner cap. The corner falls in the centerline of 11 mile rd. and on the extension of 1/4 line fences to the North and South.

Witnesses: Fence Post N 36° E 32.28'
Witness Pipe S 39° E 46.94'
Fence Post S 08° W 24.17'
Witness Pipe S 76° W 33.73'
Fence Post S 79° W 62.04'
Fence Post N 42° W 45.82'

Note: The Witness Pipes are 3/4" x 24" pipes with pipe caps set 1' below grade, the angle between the pipes being 115° 22' 15".

Bearings are compass bearings, corrected for declination, all distances are to a nail and tag in the side of the witness object unless otherwise noted.

Signed by William L. Karr

Date 12/23/97

Surveyor's Michigan License No. 27450

