

MAR 09 1994

COMMISSION

Chippewa County Remonumentation Corner

RECEIVED FOR RECORD
CHIPPEWA COUNTY
STATE OF MICHIGAN

LAND CORNER RECORDATION CERTIFICATE
Filing Requirement of Act 74, Mich. P.A. 1970

93 DEC 14 PM 4: 26

J. Roger Marlette
REGISTER OF DEEDS

For corners in

Chippewa

(County)


Located In:

Corner Code ##

1. Public Land Survey	T <u>46N</u> R <u>1E</u>	<u>E-3</u>
	T _____ R _____	_____
	T _____ R _____	_____
	T _____ R _____	_____
2. Property Controlling in Section	S _____ T _____ R _____	_____
	S _____ T _____ R _____	_____
3. Miscellaneous Property in Sec.	S _____ T _____ R _____	_____
	S _____ T _____ R _____	_____

Register of Deeds Stamp & File Number

- 4. Lot No. _____, Recorded Plat _____
- 5. Private Claims _____

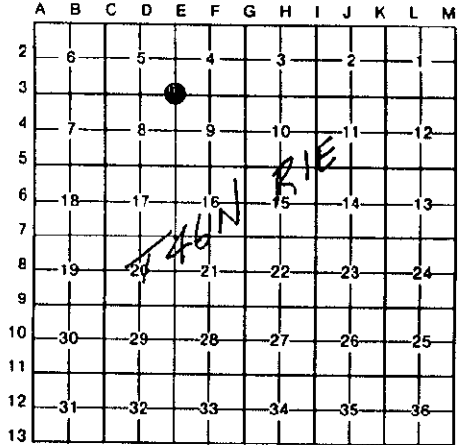

I, William L. Karr, in a field survey on November 24, 19 93, do hereby certify that under requirements of P.A. 74, Michigan P.A. of 1970, the corner points mentioned in lines 1 and 2 above were in conformance with regulations and rules therefore as required in the current manual of survey instructions of the United States Department of the Interior, Bureau of Land Management or by a decree of a Court of Law and/or that the corner points mentioned in lines 3, 4 and 5 above were in conformance with the rules of the Michigan Board of Land Surveyors or by a Decree of a Court of Law; established, re-established, monumented, re-monumented, recovered, found as expressed below:

NOTE: Not more than 4 corners, all in the same town and range, may be recorded on this certificate.

A. Description of original monument and accessories and/or subsequent restoration:
(E-3) Section Corner Common to Sections 4, 5, 8 & 9 (T46N-R1E)

This corner was recorded by L.R. Rogers, L.S. 29251 in Liber 7, Page 398 of the Chippewa County Corner Records as a 1" iron with the following witnesses:

Wood Corner Fence Post	N46°E	73.50'
Power Pole (220 DR1/107)	N56°E	86.12'
"V" Notch in C.M.P.	S62°W	44.65'
10" Spruce	N60°W	64.35'

B. Description of corner evidence found and/or method applied in restoring or reestablishing corner:
(E-3) This corner is being perpetuated as part of the Chippewa County Remonumentation Program.

Found a 1" iron with four witnesses. Spruce witness is actually a Tamarack. Accepted corner position as found and added one new witness.



C. Description of monument for corner and accessories established to perpetuate locating the position of the corner:
(E-3) Corner is a 1" iron and falls in the centerline of Shunk Road (paved) approximately 3' South of the centerline of Seven Mile Road (gravel).

Witnesses: Wood Corner Fence Post	N46°E	73.63'
Power Pole (220 DR1/107)	N56°E	86.08'
"V" Notch in C.M.P.	S62°W	44.65'
10" Tamarack	N60°W	64.35'
"V" Notch in C.M.P.	S57°E	45.04'



Signed by *William L. Karr* Date 12/14/93

Surveyor's Michigan License No. 27450

NOTE: Bearings are compass bearings corrected for declination.
 Distances are to a nail in side of witness objects unless noted.