

RECEIVED FOR RECORD
CHIPPEWA COUNTY
STATE OF MICHIGAN

MAR 09 1984

Chippewa County Remonumentation Corner

LAND CORNER RECORDATION CERTIFICATE
Filing Requirement of Act 74, Mich. P.A. 1970

93 DEC 14 PH 4: 26

J. Roger Malotte
REGISTER OF DEEDS

For corners in

Chippewa
(County)


Located In:

Corner Code #

1. Public Land Survey	T <u>46N</u> R <u>1E</u>	E-5
	T _____ R _____	_____
	T _____ R _____	_____
	T _____ R _____	_____
2. Property Controlling in Section	S _____ T _____ R _____	_____
	S _____ T _____ R _____	_____
3. Miscellaneous Property in Sec.	S _____ T _____ R _____	_____
	S _____ T _____ R _____	_____

Register of Deeds Stamp & File Number

4. Lot No. _____, Recorded Plat _____
5. Private Claims _____

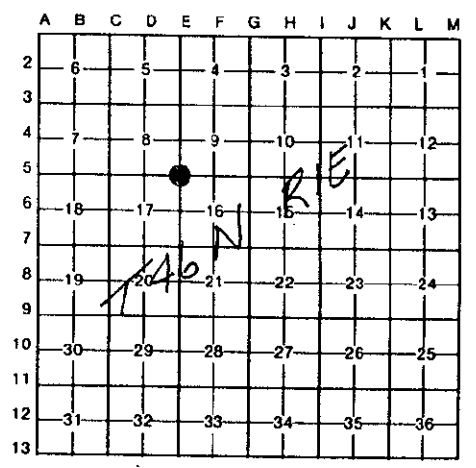

I, William L. Karr, in a field survey on November 23, 19 93

do hereby certify that under requirements of P.A. 74, Michigan P.A. of 1970, the corner points mentioned in lines 1 and 2 above were in conformance with regulations and rules therefore as required in the current manual of survey instructions of the United States Department of the Interior, Bureau of Land Management or by a decree of a Court of Law and/or that the corner points mentioned in lines 3, 4 and 5 above were in conformance with the rules of the Michigan Board of Land Surveyors or by a Decree of a Court of Law; established, re-established, monumented, re-monumented, recovered, found as expressed below:

NOTE: Not more than 4 corners, all in the same town and range, may be recorded on this certificate.

A. Description of original monument and accessories and/or subsequent restoration:

(E-5) Section Corner Common to Sections 8, 9, 16 & 17, (T46N-R1E)


This corner was recorded by Keith R. Waters, L.S. 33142 in Liber 7, Page 250 of the Chippewa County Corner Records as a 1/2" x 18" iron with cap #33142 with the following witnesses:

Power Pole	N14°E	360.22'
Power Pole	N63°E	63.62'
Power Pole	S04°E	296.50'
Fence Post	S53°W	68.34'

B. Description of corner evidence found and/or method applied in restoring or reestablishing corner:

(E-5) This corner is being perpetuated as part of the Chippewa County Remonumentation Program.

Found a 1/2" iron with cap #33142 and all witnesses as called for. Accepted corner position as found and added one witness.

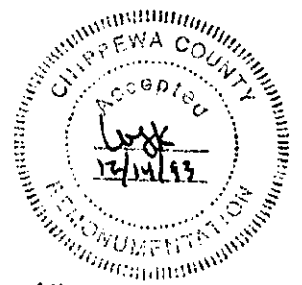

C. Description of monument for corner and accessories established to perpetuate locating the position of the corner:

(E-5) Corner is a 1/2" iron with cap #33142 at approximate intersecting centerlines of Shunk and Eight Mile Roads.

Witnesses: Power Pole	N14°E	360.22'
Power Pole	N63°E	63.58'
Power Pole	S04°E	296.50'
Fence Post	S53°W	68.34'
2nd Post North of corner fence post	N55°W	61.68'



Signed by William L. Karr Date 12/14/93

Surveyor's Michigan License No. 27450

NOTE: Bearings are compass bearings corrected for declination.
Distances are to a nail in side of witness objects unless noted.