1993

Chippewa County Remonumentation Corner

LAND CORNER RECORDATION CERTIFICATE

Filing	Requirement	of Act	74.	Mich.	P.A.	1970
			,			

For corners in DOMMISSION

RECEIVED FOR RECORD CHIPPEWA COUNTY STATE OF MICHIGAN

93 NOV 31 AM 10: 48

REGISTER OF DEEDS

Register of Deeds Stamp & File Number

Chippewa		Located In:	Corner Code ##	
	(County)		00.1101 0000	
1.	Public Land Survey	T 46N R 1E	E-7	
	, f	T R		
		T R		
	/	T R		
2.	Property Controlling	S T R		
	in Section	S T R		
3.	Miscellaneous	S T R	·	
	Property in Sec.	"S T R		

____ , Recorded Plat __

5. Private Claims ___

I, Larry R. Rogers , in a field survey on November 8 do hereby certify that under requirements of P.A. 74, Michigan P.A. of 1970, the corner points mentioned in lines 1 and 2 above were in conformance with regulations and rules therefore as required in the current manual of survey instructions of the United States Department of the Interior, Bureau of Land Management or by a decree of a Court of Law and/or that the corner points mentioned in lines 3, 4 and 5 above were in conformance with the rules of the Michigan Board of Land Surveyors or by a Decree of a Court of Law; established, re-established, monumented, re-monumented, recovered, found as expressed below:

NOTE: Not more than 4 corners, all in the same town and range, may be recorded on this certificate.

A. Description of original monument and accessories and/or subsequent restoration:


(E-7) Section Corner Common to Sections 16, 17, 20 & 21, T46N-R1E

This corner was recorded in 1984 by William L. Karr, P.S. 27450 in Liber 6, Page 1496p, of the Chippewa County Corner Records as a 1" iron pipe with the following witnesses:

16" Spruce	S60°W	101.18'
Power Pole (DRI/76/1)	N37°E	72.08'
Power Pole	S26°E	47.47'
Power Pole (DRI/76/1A)	N32°W	63.50′

B. Description of corner evidence found and/or method applied in restoring or reestablishing corner:

This corner is being perpetuated as part of the Chippewa (E-7) County Remonumentation Program.

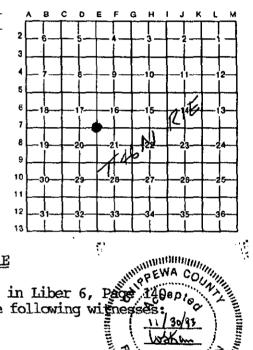

