

MAY 28 1997

COMMISSION

LAND CORNER RECORDATION CERTIFICATE
Filing Requirement of Act 74, Mich. P.A. 1970
Chippewa County Remonumentation Corner


For corners in

Table with columns: Chippewa County, Located in:, Corner Code #. Rows include Public Land Survey, Property Controlling in Section, Miscellaneous Property in Sec., Lot No., and Private Claims.

\$7.00 LAND CORNER
\$2.00 NCSR
2/28/1997 3:09:23 PM Receipt #217
RECEIVED FOR RECORD
CHIPPWEA COUNTY - STATE OF MICHIGAN
B. J. KENNEDY, REGISTER OF DEEDS
BOOK 9 PAGE 371
Register of Deeds Stamp & File Number

I, William L. Karr, in a field survey on December 3, 1996, do hereby state that under requirements of P.A. 74, Michigan P.A. of 1970, the corner points mentioned in lines 1 and 2 above were in conformance with regulations and rules therefore as required in the current manual of survey instructions of the United States Department of the Interior, Bureau of Land Management or by a decree of a Court of Law and/or that the corner points mentioned in lines 3, 4 and 5 above were in conformance with the rules of the Michigan Board of Land Surveyors or by a Decree of a Court of Law; established, re-established, monumented, recovered, found as expressed below:

NOTE: Not more than 2 corners, all in the same town and range, may be recorded on this certificate.

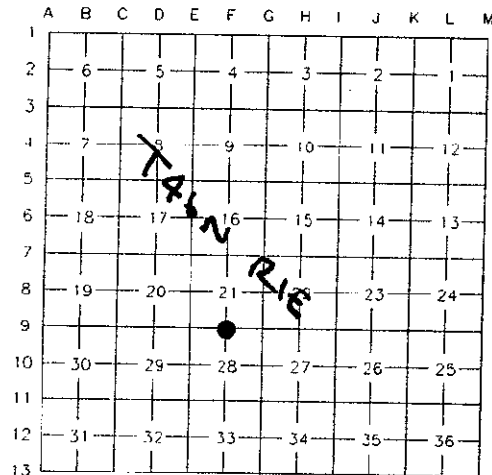

A. Description of original monument and accessories and/or subsequent restoration:

(F-9) 1/4 Corner Common to Sections 21 & 28, T. 46 N., R. 1 E.

1845 J.H. Mullett set post in original survey.

1902 F.H. Brown in records in County Surveyors Office for a survey in section 28 shows the West 1/2 mile as 2636' measured. And the East 1/2 mile as 2646' computed. Brown does not say what the corner is.

1992 L.R. Rogers in a survey in section 21, Northwoods Land Surveying Job 419-37, shows corner position reestablished on line between the section corners East and West and on the range of a fence to the North.

B. Description of corner evidence found and/or method applied in restoring or reestablishing corner:

(F-9) 1/4 Corner Common to Sections 21 & 28, T. 46 N., R. 1 E.

This corner is being perpetuated as part of the Chippewa County Remonumentation Program.

Found no evidence of original or subsequent survey work. Accepted position as established in Rogers's 1992 survey and re-set corner on line between section corners and on range of fence to North. Distance to the section corner to West is 2642.7' and to the East is 2645.1'.

C. Description of monument for corner and accessories established to perpetuate locating the position of the corner:

(F-9) 1/4 Corner Common to Sections 21 & 28, T. 46 N., R. 1 E.

Corner is a 3/4" x 24" re-bar with plastic Chippewa County Remonumentation Cap. Corner falls 6' South of an East-West 2 track road and on the range of an old fence to the North, 22.3' South of the fence corner.

Table with columns: Witnesses, Bearing, Distance. Rows include 6" Cedar, 8" Spruce, 10" Spruce, 6" Spruce.

Bearings are compass bearings, corrected for declination, all distances are to a nail and tag in the side of the witness object unless otherwise noted.

Signed by William L. Karr

Date 12-30-96

Surveyor's Michigan License No. 27450

