

APR 07 1998

PK: 11/7/97

SECTION


LAND CORNER RECORDATION CERTIFICATE
Filing Requirement of Act 74, Mich. P.A. 1970
Chippewa County Remonumentation Corner

For corners in

Table with columns: Chippewa County, Located in:, Corner Code #. Rows include Public Land Survey, Property Controlling in Section, Miscellaneous, and Lot No. / Recorded Plat.

\$7.00 LAND CORNER
\$2.00 MSSR
18 Feb 1998 1:41:50 PM Receipt #6148
RECEIVED FOR RECORD
CHIPPEWA COUNTY - STATE OF MICHIGAN
SHARON H. KENNEDY, REGISTER OF DEEDS

BOOK 10 PAGE 154
Register of Deeds Stamp & File Number

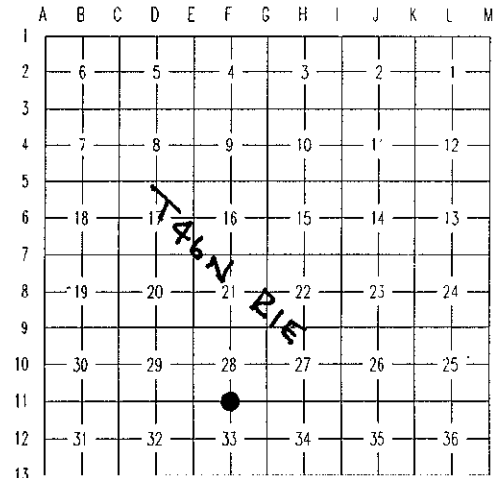

I, William L. Karr, in a field survey on October 27, 1997, do hereby state that under requirements of P.A. 74, Michigan P.A. of 1970, the corner points mentioned in lines 1 and 2 above were in conformance with regulations and rules therefore as required in the current manual of survey instructions of the United States Department of the Interior, Bureau of Land Management or by a decree of a Court of Law and /or that the corner points mentioned in lines 3, 4 and 5 above were in conformance with the rules of the Michigan Board of Land Surveyors or by a Decree of a Court of Law, established, re-established, monumented, recovered, found as expressed below:

NOTE: Not more than 2 corners, all in the same town and range, may be recorded on this certificate.

A. Description of original monument and accessories and/or subsequent restoration:

(F-11) 1/4 Corner Common to Sections 28 and 33, T. 46 N., R. 1 E.

1845 J.H. Mullett set post for corner in original survey
Witnesses: Fir N 02° W 19 lks
Birch S 39° E 16 lks

1902 F.H. Brown in field book in County Surveyors Office for a survey of section 33 shows the mile to be 5291' and evenly divided.

1915 F.H. Brown in field book in County Surveyors Office for additional work in section 33 shows the mile to be 5286' with the West half being 2640' and a fence to the North at the 1/4 corner.

B. Description of corner evidence found and/or method applied in restoring or reestablishing corner:

(F-11) 1/4 Corner Common to Sections 28 and 33, T. 46 N., R. 1 E.

This corner is being perpetuated as part of the Chippewa County Remonumentation Program.

Found no evidence of the original corner. Found an old fence to the South and the remains of very old fence to the North. The mile measures 5288' and a proration of the 1915 County Surveyor distances matches the fences and falls in the centerline of an East-West road. Reestablished the corner by proportionate measurement using the 1915 County Surveyor distances between the section corners to the East (2646' C.S., 2647.36' meas.) and West (2640' C.S., 2641.00' meas.).

C. Description of monument for corner and accessories established to perpetuate locating the position of the corner:

(F-11) 1/4 Corner Common to Sections 28 and 33, T. 46 N., R. 1 E.

The corner is a 3/4" x 24" re-bar with plastic Chippewa County Remonumentation Corner cap set 6" below grade and in the centerline of 11 mile road (East-West).

Witnesses: 20" Spruce N 65° E 70.14'
Fence Post S 39° E 38.90'
12" Maple S 62° W 85.51'
14" Maple N 55° W 61.77'

Bearings are compass bearings, corrected for declination, all distances are to a nail and tag in the side of the witness object unless otherwise noted.

Signed by [Signature]

Date 12/23/97

Surveyor's Michigan License No. 27450

