

LAND CORNER RECORDATION CERTIFICATE
Filing Requirement of Act 74, Mich. P.A. 1970


93 DEC 30 PM 2:43

For corners in
Chippewa

MAR 03 1994

Located In: _____ Corner Code: # _____

- 1. Public Land Survey T 46N R 1E F-13
- T _____ R _____
- T _____ R _____
- T _____ R _____
- 2. Property Controlling S _____ T _____
- in Section S _____ T _____
- 3. Miscellaneous S _____ T _____
- Property in Sec. S _____ T _____
- 4. Lot No. _____ Recorded Plat _____
- 5. Private Claims _____

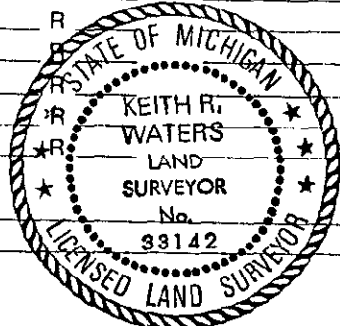

J. Roger Malott
REGISTER OF DEEDS

Register of Deeds Stamp & File Number

	A	B	C	D	E	F	G	H	I	J	K	L	M
2	6	5	4	3	2	1							
3													
4	7	8	9	10	11	12							
5													
6	18	17	16	15	14	13							
7													
8	19	20	21	22	23	24							
9													
10	30	29	28	27	26	25							
11													
12	31	32	33	34	35	36							
13													

I, Keith R. Waters in a field survey on December 16, 19 93, do hereby certify that under requirements of P.A. 74, Michigan P.A. of 1970, the corner points mentioned in lines 1 and 2 above were in conformance with regulations and rules therefore as required in the current manual of survey instructions of the United States Department of the Interior, Bureau of Land Management or by a decree of a Court of Law and/or that the corner points mentioned in lines 3, 4 and 5 above were in conformance with the rules of the Michigan Board of Land Surveyors or by a Decree of a Court of Law; established, re-established, monumented, re-monumented, recovered, found as expressed below:


NOTE: Not more than 4 corners, all in the same town and range, may be recorded on this certificate.

A. Description of original monument and accessories and/or subsequent restoration:

F-13 (T46N, R1E) South 1/4 Corner of Section 33, T46N, R1E
 Original ties to post: Birch 10, N38°E 20 links Fir 12, N36°W 43 links (1980):
 This corner is shown on a survey recorded in liber 2 of Surveys, page 166, by Thomas M. Kelly, R.L.S. 24599, as a 1/2" rerod 2646.67 feet east of Southwest corner of Section 33. Witnesses: Power Pole, S44°W 74.80'
 6" Spruce, S31°E 46.26'
 8" Poplar, N52°E 80.22'

B. Description of corner evidence found and/or method applied in restoring or reestablishing corner:

F-13 (T46N, R1E)
 This corner is being re-established as part of the Chippewa County Remonumentation Program.
 Found no evidence of corner. Re-established corner mid-way on line between common section corner 2647.10 feet east and standard section corner 2647.10 feet west. Distance to standard section corner west is within 0.43 feet of that as shown on recorded Kelly survey. Power pole southwest of corner appears to be the same one as shown as a witness on Kelly survey, however it is not clear what point distance was taken to. Distance to face of pole checks well.

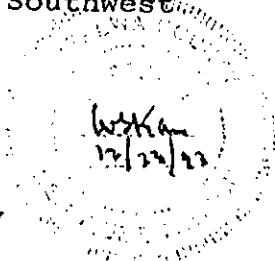

C. Description of monument for corner and accessories established to perpetuate locating the position of the corner:

F-13 (T46N, R1E)
 Corner is a 3/4" x 24" rebar with plastic Chippewa County Remonumentation cap 1.5 feet north of centerline of east-west asphalt road (12 Mile Road).
 Witnesses:
 SE Corner of House Foundation, N29°W 108.58'
 Power Pole (DR1-76-51), S49°W 75.38'
 7" Jack Pine, S03°E 73.31'
 4" Spruce, N57°E 77.89'
 1/2" Iron w/cap #29251, WEST 1.92' (N 1/4 Cor. Sec. 4, T45N, R1E)
 Note: Unless noted otherwise, distances are to a nail and tag in the side of the witness object. Trees are blazed and painted. Bearings are compass bearings corrected for declination.

Signed by Keith R. Waters Date 12-30-93

Surveyor's Michigan License No. 33142