

MAR 09 1994

LAND CORNER RECORDATION CERTIFICATE
Filing Requirement of Act 74, Mich. P.A. 1970

93 DEC 14 PM 4:26

For corners in Chippewa


Chippewa (County)	Located In:	Corner Code #
1. Public Land Survey	T <u>46N</u> R <u>1E</u>	<u>G-4</u>
	T _____ R _____	_____
	T _____ R _____	_____
	T _____ R _____	_____
2. Property Controlling in Section	S _____ T _____ R _____	_____
	S _____ T _____ R _____	_____
3. Miscellaneous Property in Sec.	S _____ T _____ R _____	_____
	S _____ T _____ R _____	_____

J. Roger Malott
REGISTER OF DEEDS

Register of Deeds Stamp & File Number

4. Lot No. _____, Recorded Plat _____
5. Private Claims _____

I, William L. Karr, in a field survey on November 24, 19 93, do hereby certify that under requirements of P.A. 74, Michigan P.A. of 1970, the corner points mentioned in lines 1 and 2 above were in conformance with regulations and rules therefore as required in the current manual of survey instructions of the United States Department of the Interior, Bureau of Land Management or by a decree of a Court of Law and/or that the corner points mentioned in lines 3, 4 and 5 above were in conformance with the rules of the Michigan Board of Land Surveyors or by a Decree of a Court of Law; established, re-established, monumented, re-monumented, recovered, found as expressed below:

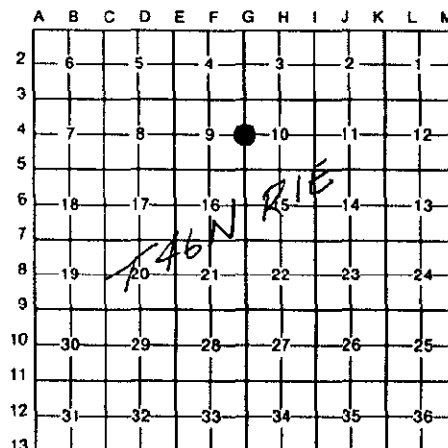

NOTE: Not more than 4 corners, all in the same town and range, may be recorded on this certificate.

A. Description of original monument and accessories and/or subsequent restoration:

(G-4) 1/4 Corner Common to Sections 9 & 10, (T46N-R1E)


This corner was recorded by W.L. Karr, L.S. 27450 in Liber 5, Page 371 of the Chippewa County Corner Records as a 1/2" iron with cap #27450 with the following witnesses:

Power Pole	N17°E	128.38'
4" Spruce	S89°E	82.18'
10" Aspen	N54°W	93.24'

B. Description of corner evidence found and/or method applied in restoring or reestablishing corner:

(G-4) This corner is being perpetuated as part of the Chippewa County Remonumentation Program.

Found a 1/2" iron with cap #27450 and three witnesses. Accepted corner position as found and added two new witnesses.

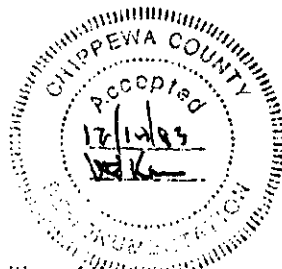

C. Description of monument for corner and accessories established to perpetuate locating the position of the corner.

(G-4) Corner is a 1/2" iron with cap #27450 and falls on the centerline of North-South gravel road.

Witnesses: Power Pole	N17°E	128.35'
10" Spruce	S89°E	82.18'
14" Aspen	N54°W	93.19'
5" White Birch	S78°W	232.43'
5" Spruce	N47°W	51.02'



Signed by William L. Karr Date 12/14/93

Surveyor's Michigan License No. 27450

NOTE: Bearings are compass bearings corrected for declination.
Distances are to a nail in side of witness objects unless noted.