

SURVEY &
REMONUMENTATION

MAY 28 1997

COMMISSION

LAND CORNER RECORDATION CERTIFICATE
Filing Requirement of Act 74, Mich. P.A. 1970
Chippewa County Remonumentation Corner

For corners in

Chippewa County	Located in:	Corner Code #
1. Public Land Survey	T46N R1E	H-9
	T R	
	T R	
	T R	
2. Property Controlling in Section	S T R	
	S T R	
3. Miscellaneous Property in Sec.	S T R	
	S T R	
4. Lot No.		Recorded Plat
5. Private Claims		

\$7.00 LAND CORNER

\$2.00 MSSR


2/28/1997 3:04:34 PM Receipt #217
RECEIVED FOR RECORD
CHIPPWEA COUNTY - STATE OF MICHIGAN
SHARON H. KENNEDY, REGISTER OF DEEDS

BOOK 9 PAGE 365

Register of Deeds Stamp & File Number

I, William L. Karr, in a field survey on November 12, 1996, do hereby state that under requirements of P.A. 74, Michigan P.A. of 1970, the corner points mentioned in lines 1 and 2 above were in conformance with regulations and rules therefore as required in the current manual of survey instructions of the United States Department of the Interior, Bureau of Land Management or by a decree of a Court of Law and /or that the corner points mentioned in lines 3, 4 and 5 above were in conformance with the rules of the Michigan Board of Land Surveyors or by a Decree of a Court of Law; established, re-established, monumented, recovered, found as expressed below:

NOTE: Not more than 2 corners, all in the same town and range, may be recorded on this certificate.

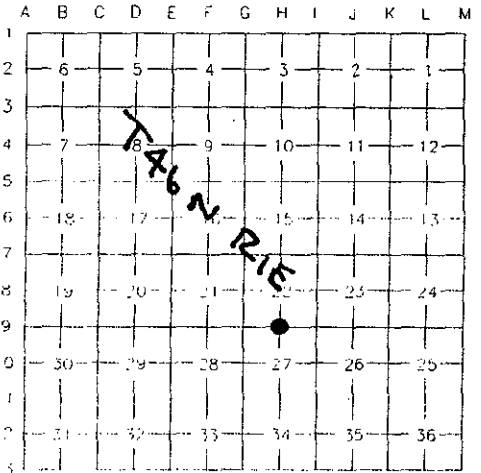

A. Description of original monument and accessories and/or subsequent restoration:

(H-9) 1/4 Corner Common to Sections 22 & 27, T. 46 N., R. 1 E.

1845 J.H. Mullett set post in original survey.

1904 F.H. Brown in records in County Surveyors Office for a survey in section 27 shows a 4" squared cedar post for corner. Brown measured 2616' to the section corner to the West and 2614.5' to the section corner to the East.


1993 W.L. Karr, PS 27450, reestablished corner position based on County Surveyor notes and set a 1/2" iron with cap no. 27450. Recorded corner in Liber 8, Page 256, Chippewa County Corner Records.

B. Description of corner evidence found and/or method applied in restoring or reestablishing corner:

(H-9) 1/4 Corner Common to Sections 22 & 27, T. 46 N., R. 1 E.

This corner is being perpetuated as part of the Chippewa County Remonumentation Program.

Found iron with cap and witnesses as recorded by Karr in 1993 and accepted corner as found.

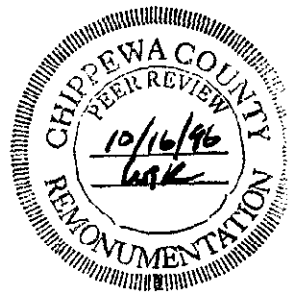

C. Description of monument for corner and accessories established to perpetuate locating the position of the corner:

(H-9) 1/4 Corner Common to Sections 22 & 27, T. 46 N., R. 1 E.

Corner is a 1/2" x 24" re-bar with plastic cap no. 27450. Corner falls 3' South of centerline of East-West gravel road and is 0.8' below grade.

Witnesses:	"V" filed in South edge of North span of old bridge.	N 84° E 70.11'
	West post of gate	S 04° E 18.36'
	4" Elm	S 75° W 62.55'
	Corner Fence Post	N 55° W 30.98'



Bearings are compass bearings, corrected for declination, all distances are to a nail and tag in the side of the witness unless otherwise noted.

Signed by William L. Karr

Date 12-30-96

Surveyor's Michigan License No. 27450